


T.9S.R.2E.W.M.

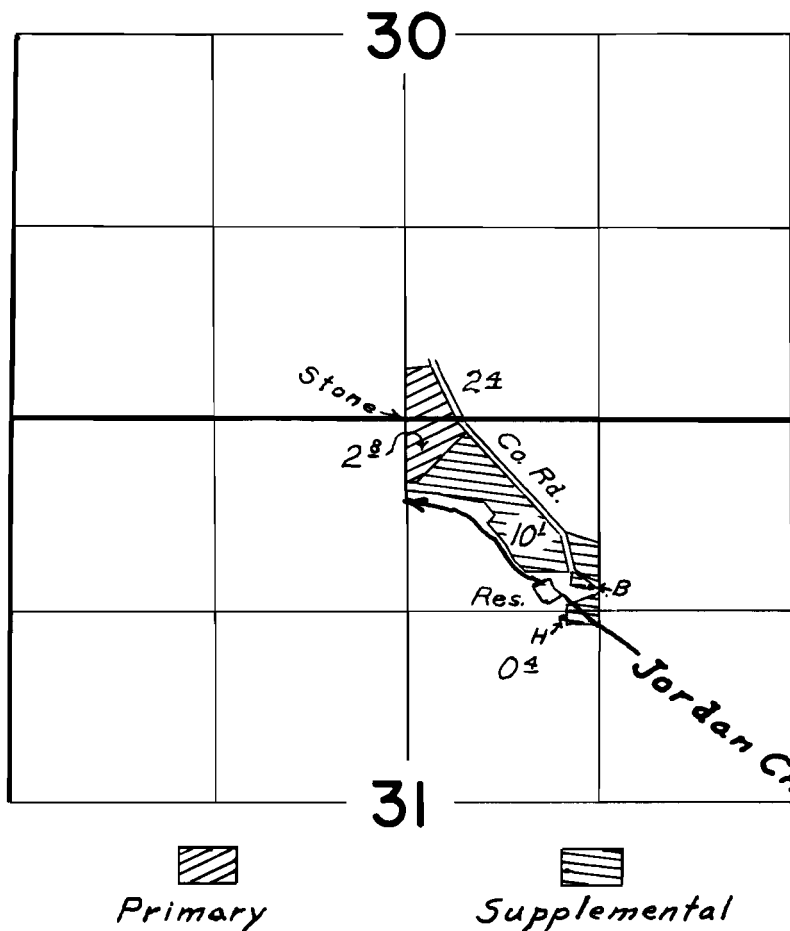

FINAL PROOF SURVEY  
UNDER

33681 26625  
Application No. R-33680 Permit No. R-2334  
IN NAME OF

James & Effie Toomb

Surveyed April 2 1962, by Thomas R. Lauer