


T. 11 S. R. 1 W. W. M.

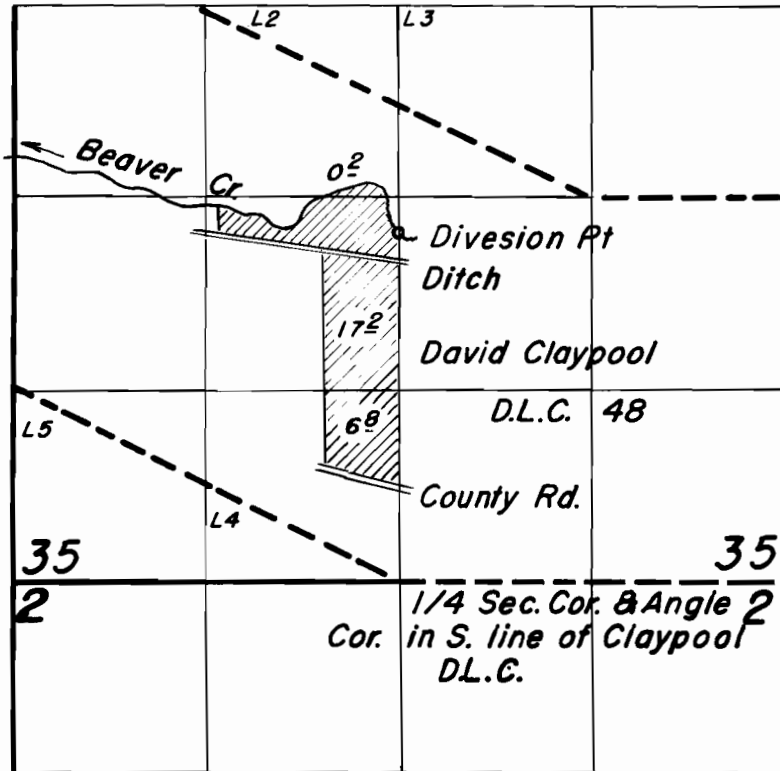

FINAL PROOF SURVEY UNDER

Application No. 34602 Permit No. 27170
IN NAME OF

Edward T. & Marie C. Goergen

Surveyed Dec. 12, 1962, by Floyd L. Siegmund