


T.7S.R.2E.W.M.

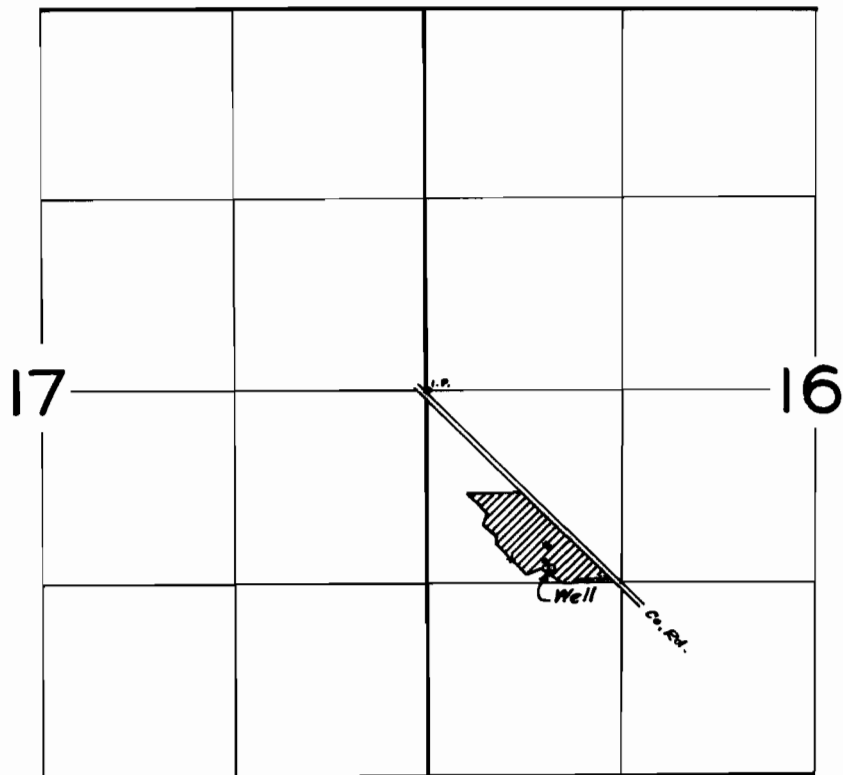

FINAL PROOF SURVEY
UNDER

Application No. G-1079.. Permit No. G-1031...
IN NAME OF

Estate of Caesar Don Ventura

Surveyed May 17, 1962, by *L. Jackson*