


# T.6S.R.2W.W.M.

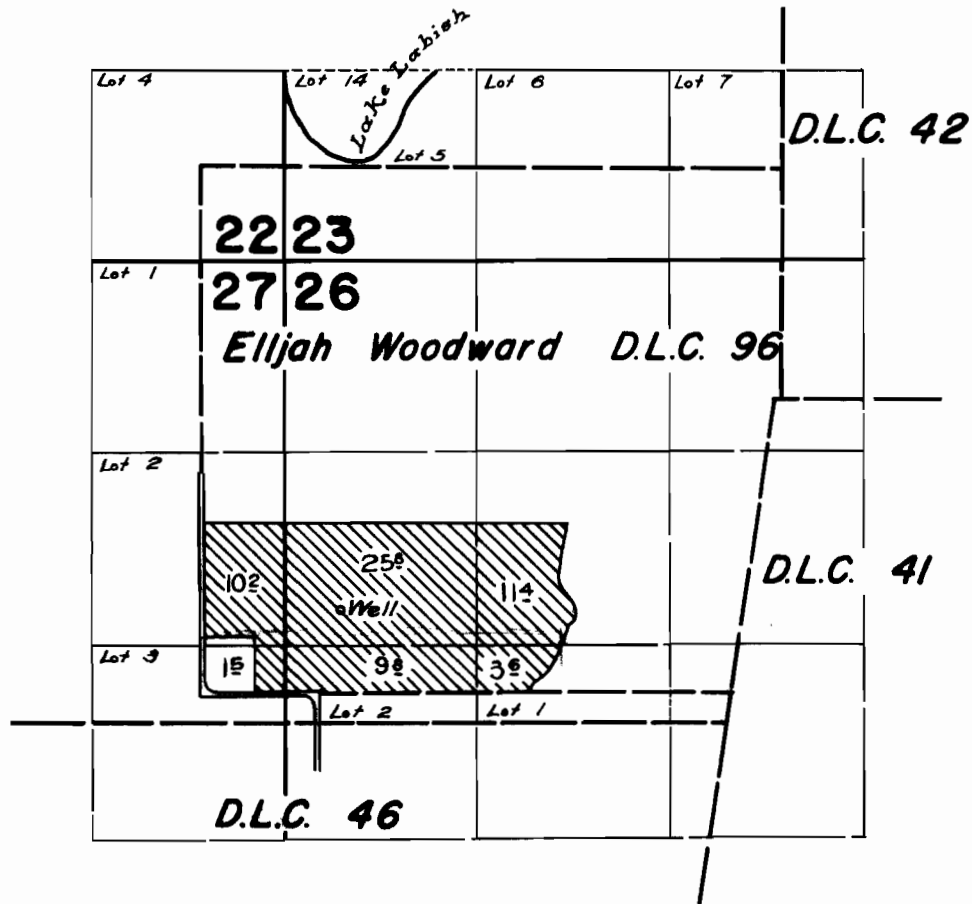

## FINAL PROOF SURVEY UNDER

Application No. G-1245.. Permit No. G-1076..  
IN NAME OF

ALBERT J. HASLEBACHER

Surveyed March 30 1962, by

*[Signature]*