


T.6S.R.2W.W.M.

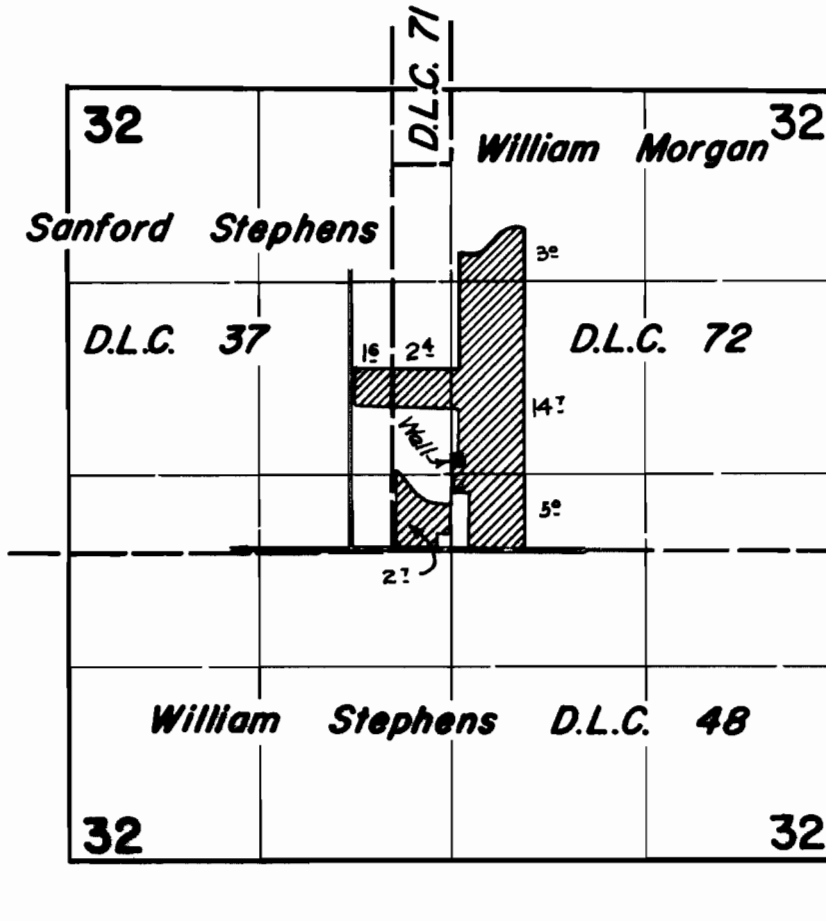

FINAL PROOF SURVEY UNDER

Application No. G-1247. Permit No. G-1077.
IN NAME OF

WALDO GILBERT

Surveyed March 23, 1962, by