


T.6S.R.1W.W.M.

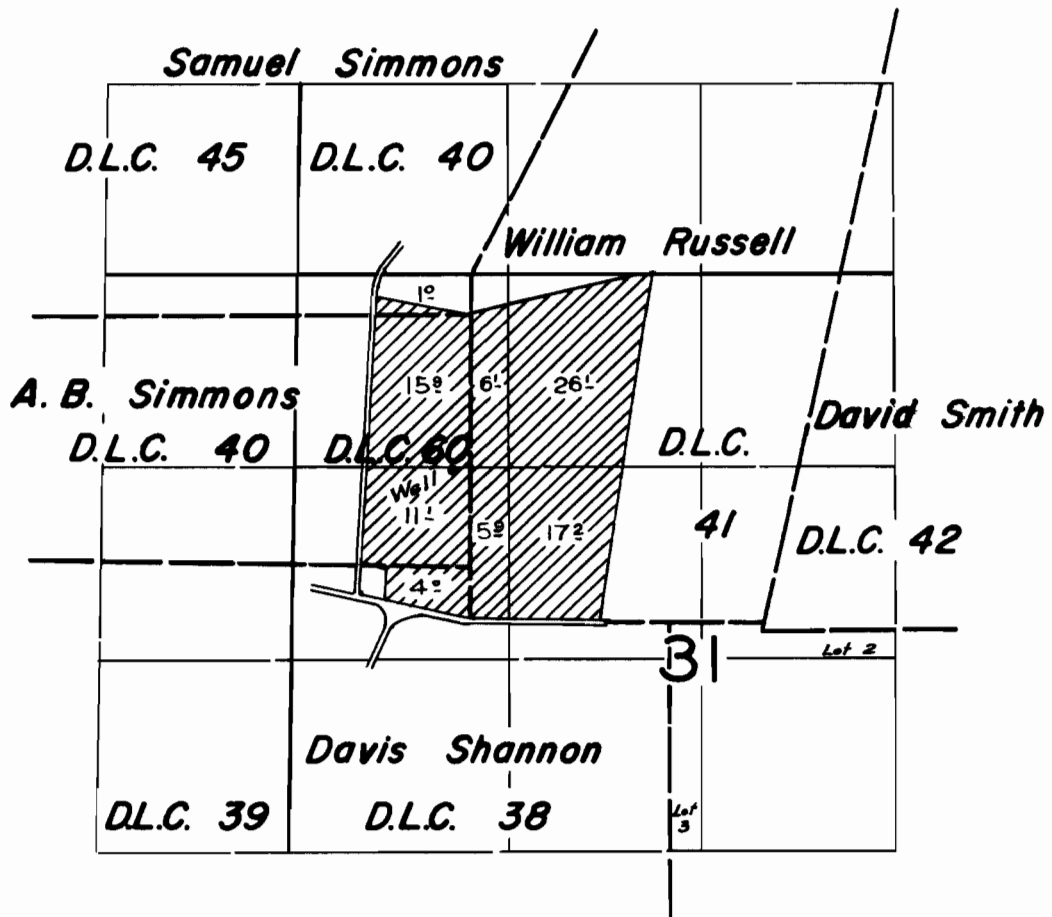

FINAL PROOF SURVEY
UNDER

Application No. G-1423. Permit No. G-1262.
IN NAME OF

JOHN E. SIEMS

Surveyed April 18, 1962, by