


T.6S.R.1&2W.W.M.

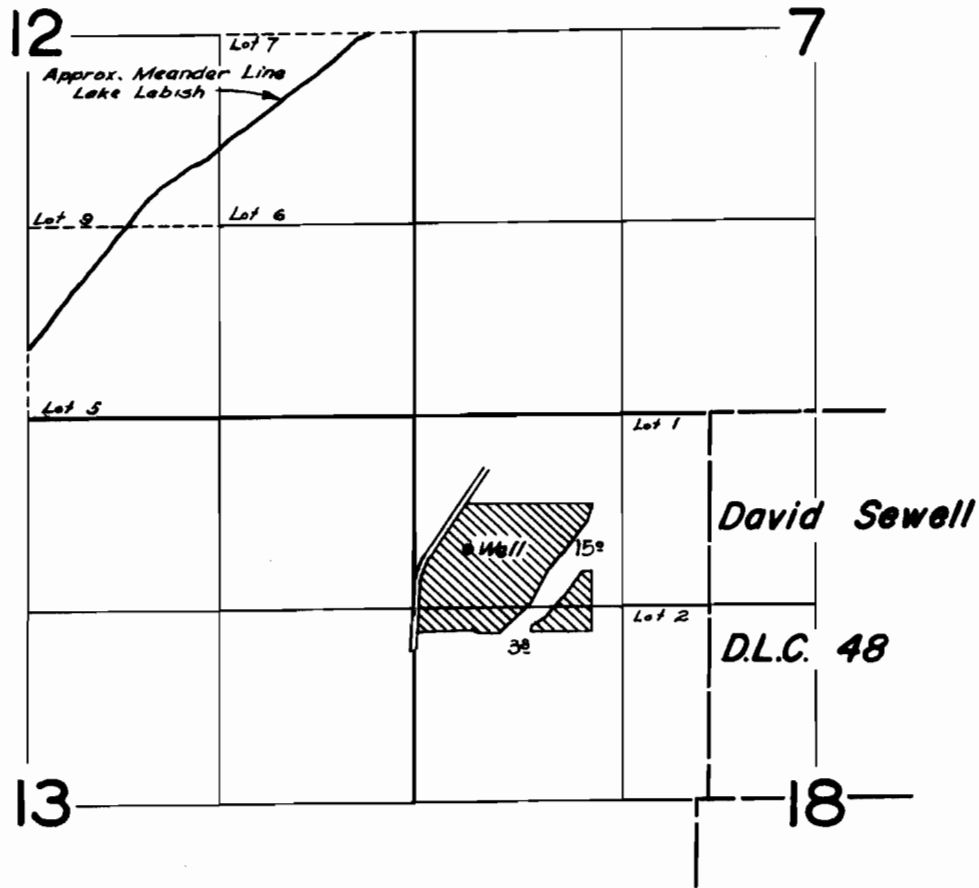

FINAL PROOF SURVEY
UNDER

Application No. G-1447. Permit No. G-1309.
IN NAME OF

JAMES HOLLIN

Surveyed April 20, 1962, by *[Signature]*