


T.8S.R.3W.W.M.

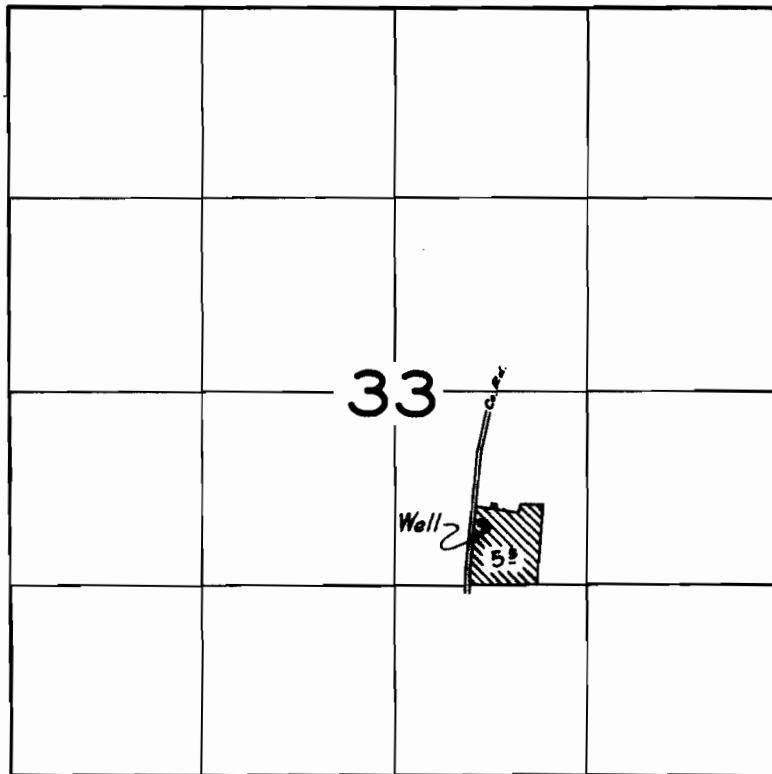

FINAL PROOF SURVEY
UNDER

Application No. **G-1509**... Permit No. **G-1380**....
IN NAME OF

WALTER A. COSMAN

Surveyed May...31... 1962., by *Alpherson*