


T.7S.R.2E.W.M.

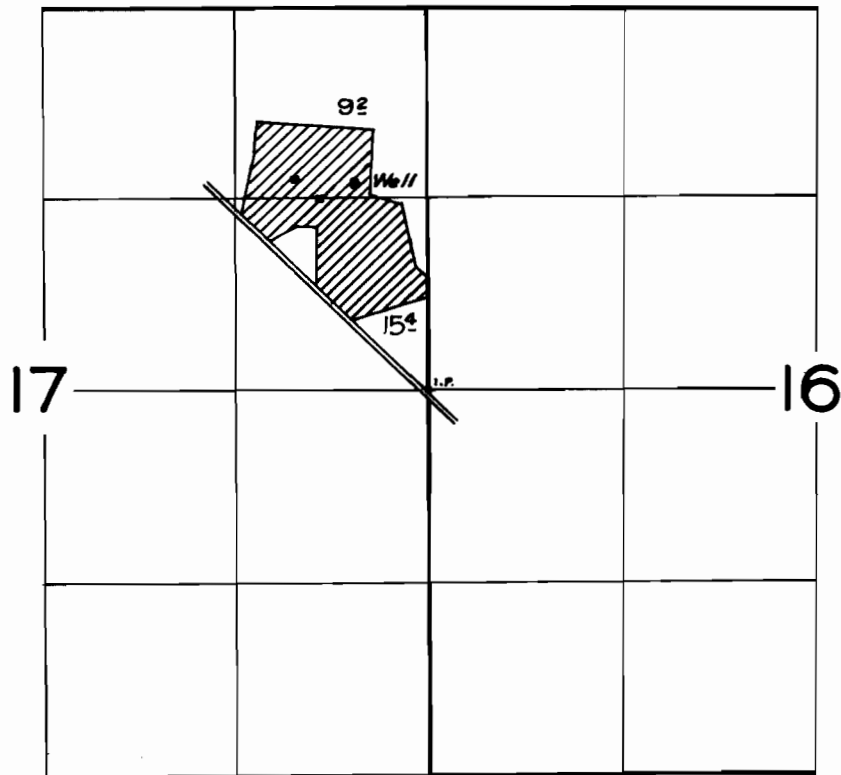

FINAL PROOF SURVEY
UNDER

Application No. G-1540. Permit No. G-1425.
IN NAME OF

TALMADGE SHIPP

Surveyed May 17, 1962, by

A. Jackson