


# T.6 S.R. I W.W.M.

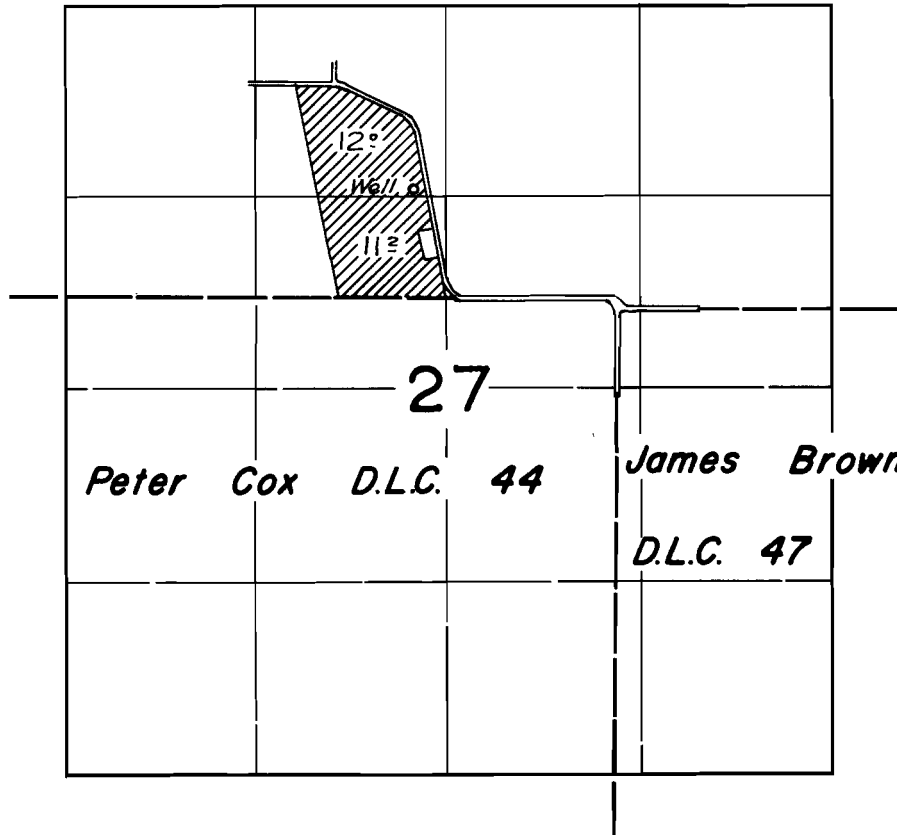

## FINAL PROOF SURVEY UNDER

Application No. G-1632... Permit No. G-1497...  
IN NAME OF

G. E. ENGEMAN

Surveyed April 18 1962, by *Johnson*