


T.6S.R.3W.W.M.

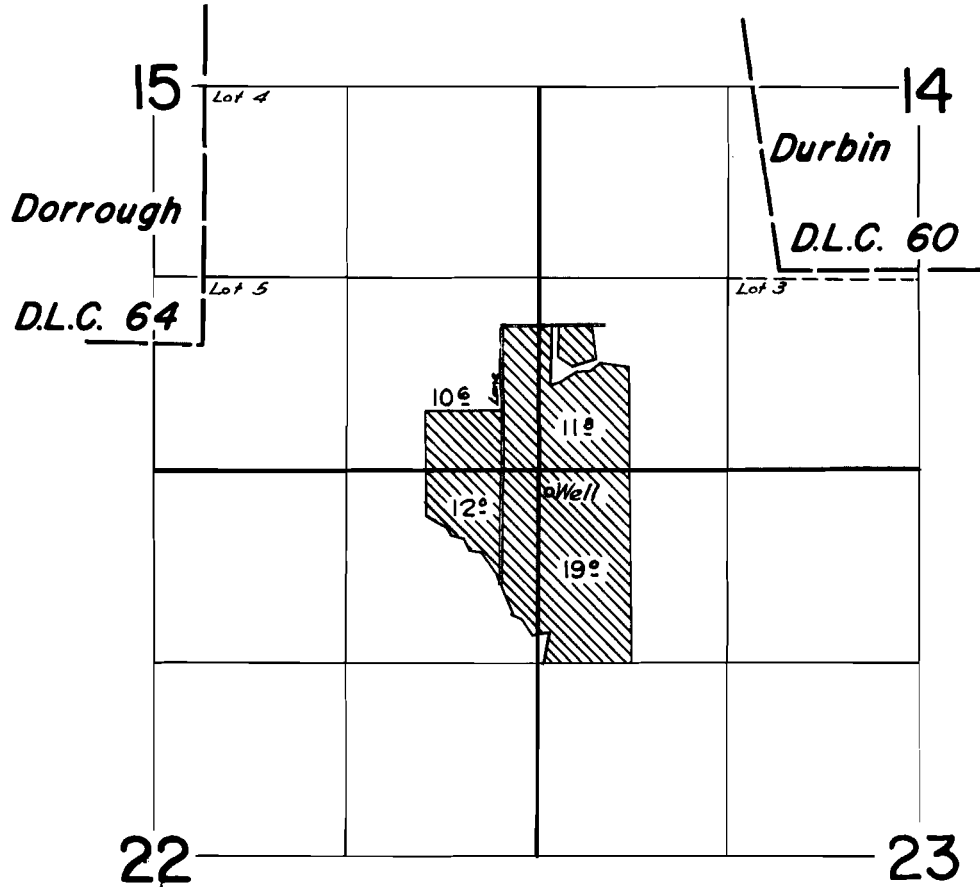

**FINAL PROOF SURVEY**  
UNDER

Application No. G-2015.. Permit No. G-1855....  
IN NAME OF

**JOHN WALLACE GRAHAM**

Surveyed March..29 1962, by *[Signature]*