


T.5S.R.3W.W.M.

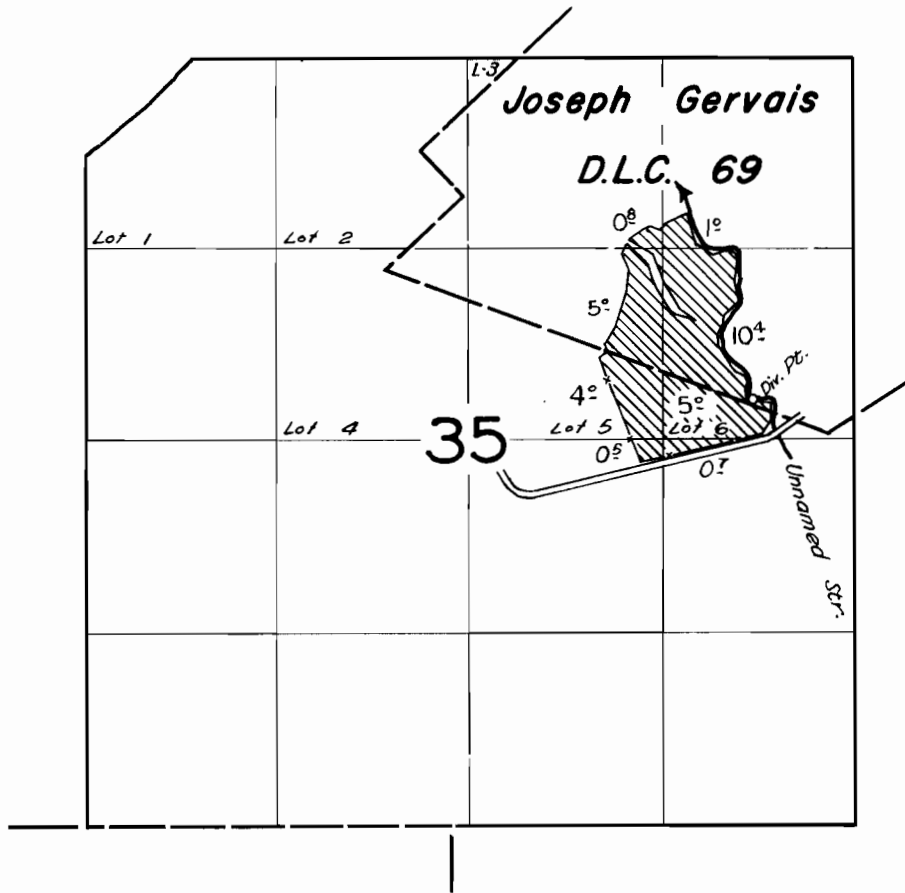

FINAL PROOF SURVEY
UNDER

Application No. 31498... Permit No. 24850...
IN NAME OF

FRED VIESKO

Surveyed May 28 1962, by *[Signature]*