


T.7S.R.1E.W.M.

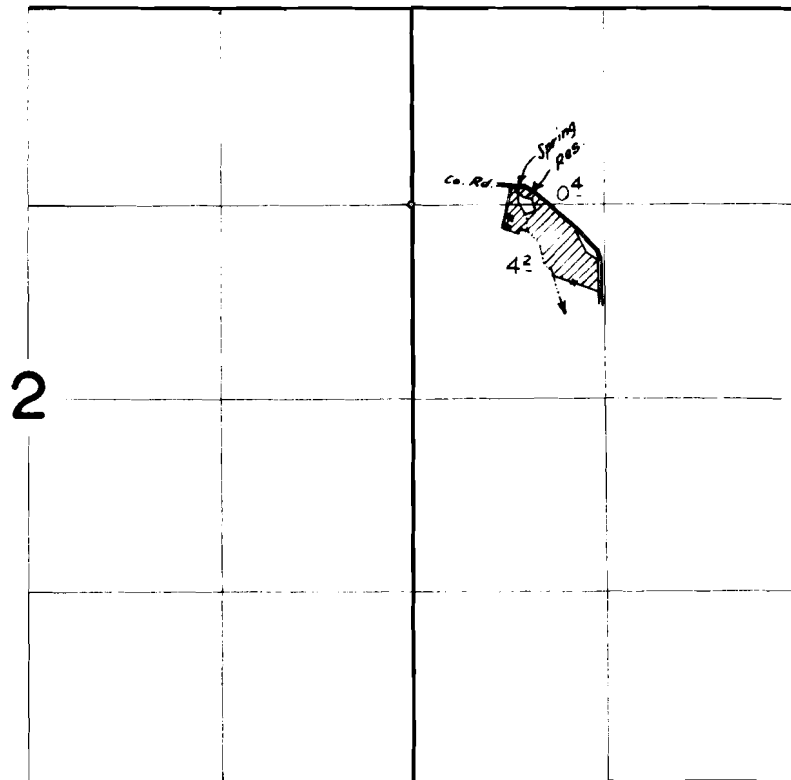

FINAL PROOF SURVEY
UNDER

Application No. **R-31909** **31910** Permit No. **R-2084** **25161**
IN NAME OF

DANIEL S. POTTER

Surveyed May 15, 1962, by *Sheldon*