


T. 8 S. R. 2 W. W.M.

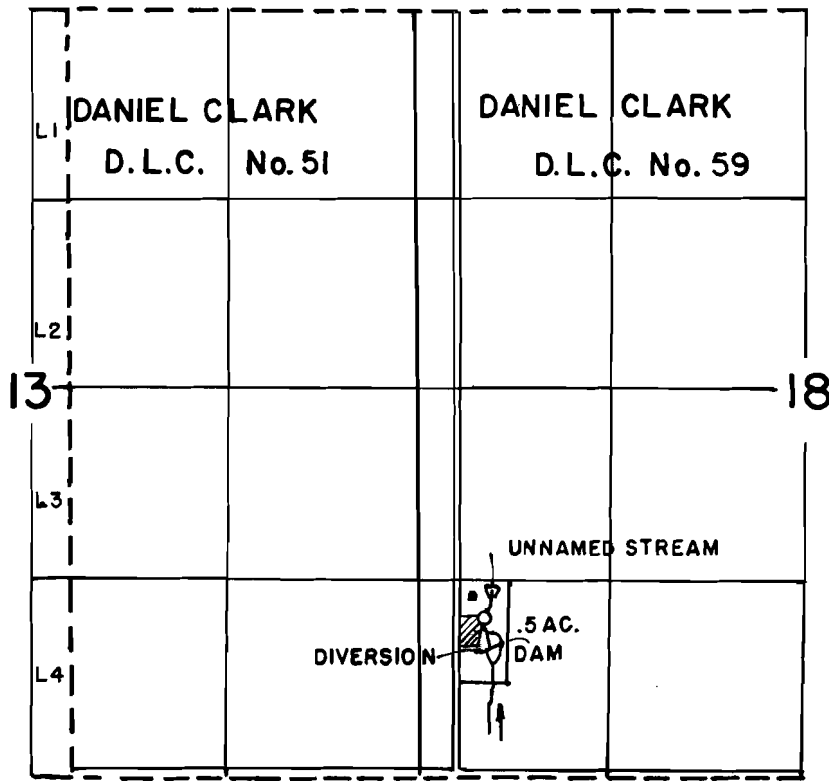

FINAL PROOF SURVEY
UNDER

31937

25181

Application No. R. 31936 Permit No. R-2086
IN NAME OF

ARTHUR P. MARTIN

Surveyed 25 OCT 1962, by *Gloyd L. Siegmund*