


T. 8 S. R. 2 W. W.M.

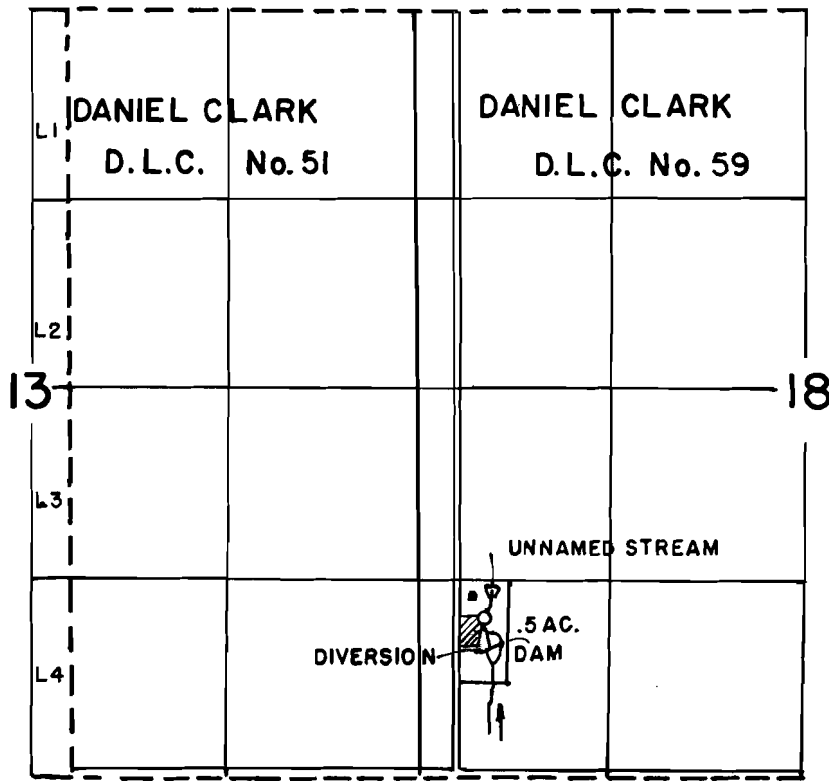

**FINAL PROOF SURVEY**  
UNDER

31937

25181

Application No. R. 31936 Permit No. R-2086  
IN NAME OF

**ARTHUR P. MARTIN**

Surveyed 25 OCT 1962, by *Floyd L. Siegmund*