


T.4 S.R.1&2 W.W.M.

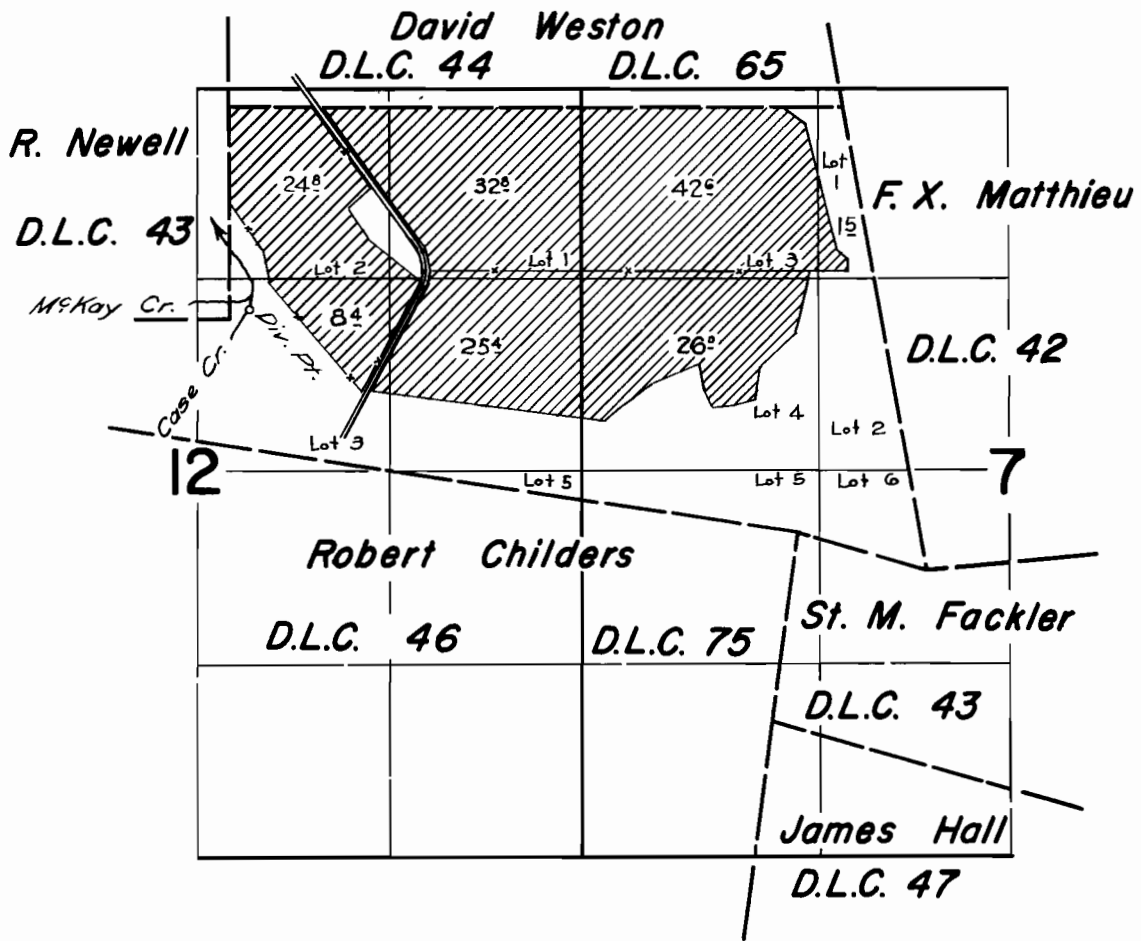

FINAL PROOF SURVEY UNDER

Application No. 322.64.. Permit No. 254.50..
IN NAME OF

FRANCIS ITEL

Surveyed March 28 1962, by *R. Jackson*