


T.4S.R.1W.W.M.

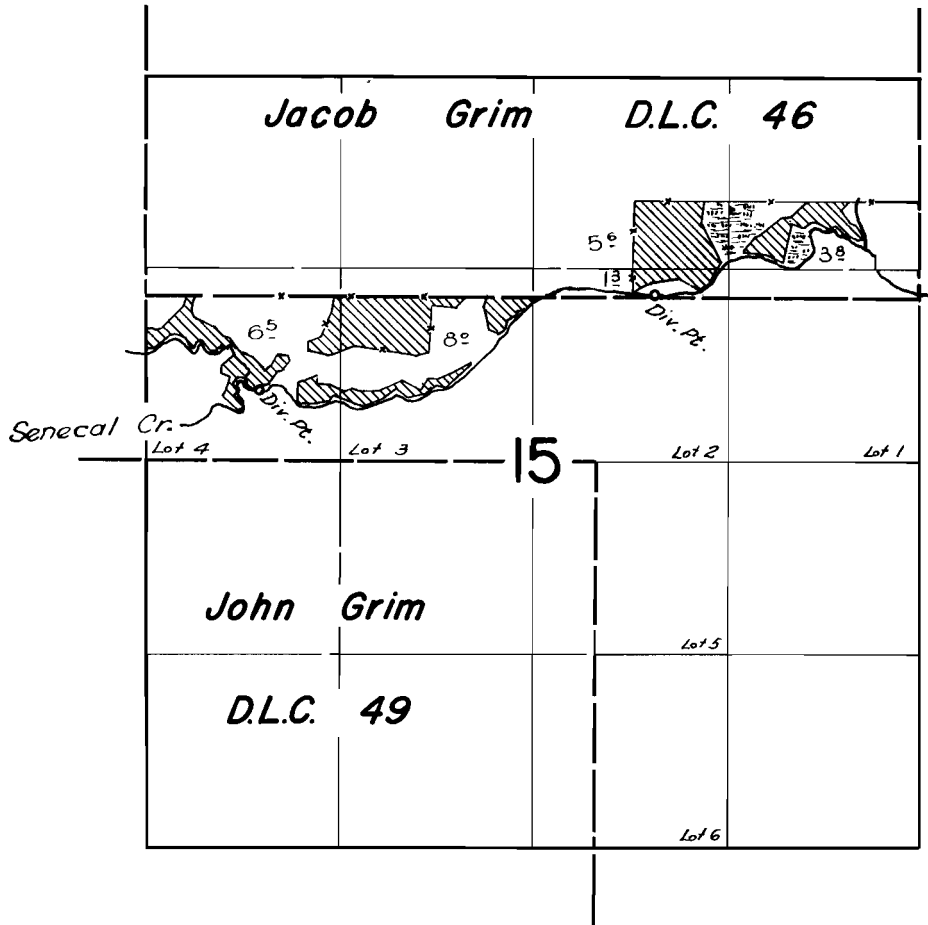

**FINAL PROOF SURVEY**  
UNDER

Application No. **32126** Permit No. **25663**  
IN NAME OF

**EMIL ZWICKER**

Surveyed April 17-18 1962, by *H. Jackson*