
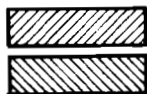


T.7S.R.1W.W.M.

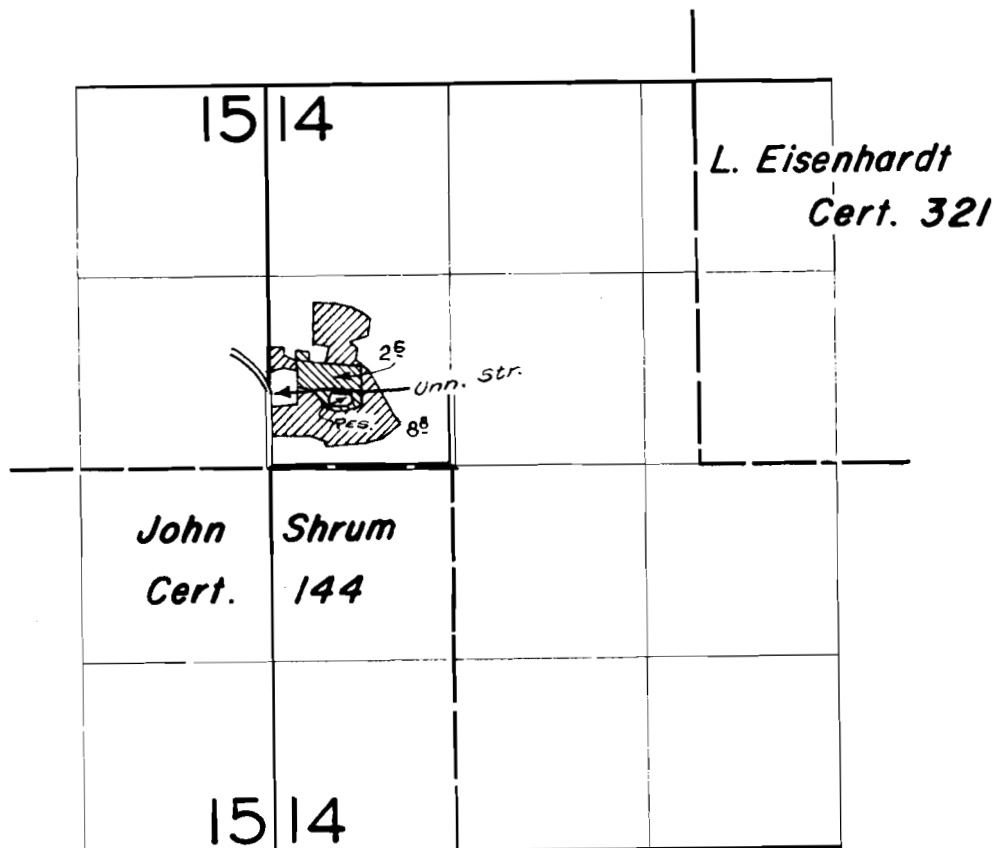

Primary

Supplemental to
Cert. 22200

FINAL PROOF SURVEY
UNDER

Application No. **R-32604**
32787 Permit No. **R-2196**
25868
IN NAME OF

MARGARET KLOPFENSTEIN

Surveyed May 14 1962 by *L. Jackson*