


T. 8 S. R. 3 W. W.M.

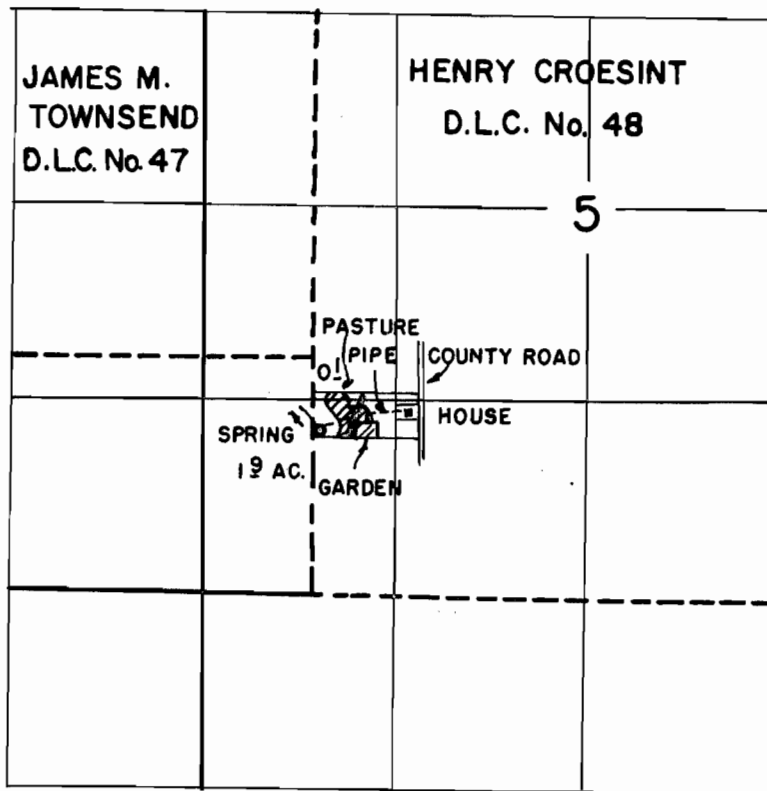

FINAL PROOF SURVEY
UNDER

Application No. 32970... Permit No. 26118.....
IN NAME OF

Martin W. Ward

Surveyed Nov. 5..... 1962, by