


T.7S.R.1W.W.M.

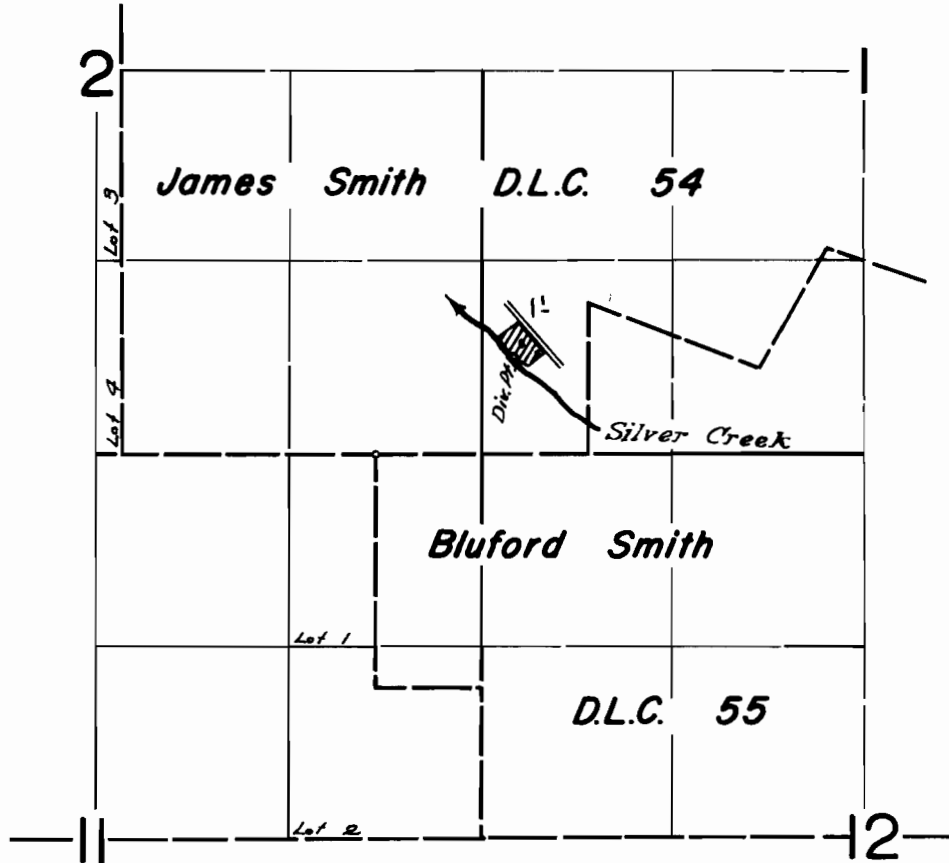

FINAL PROOF SURVEY
UNDER

Application No. 34.034... Permit No. 26838.
IN NAME OF

JOHN S. YOERGER

Surveyed May 14, 1962, by

A. Jackson