


T.5&6S.R.1W.&IE.W.M.

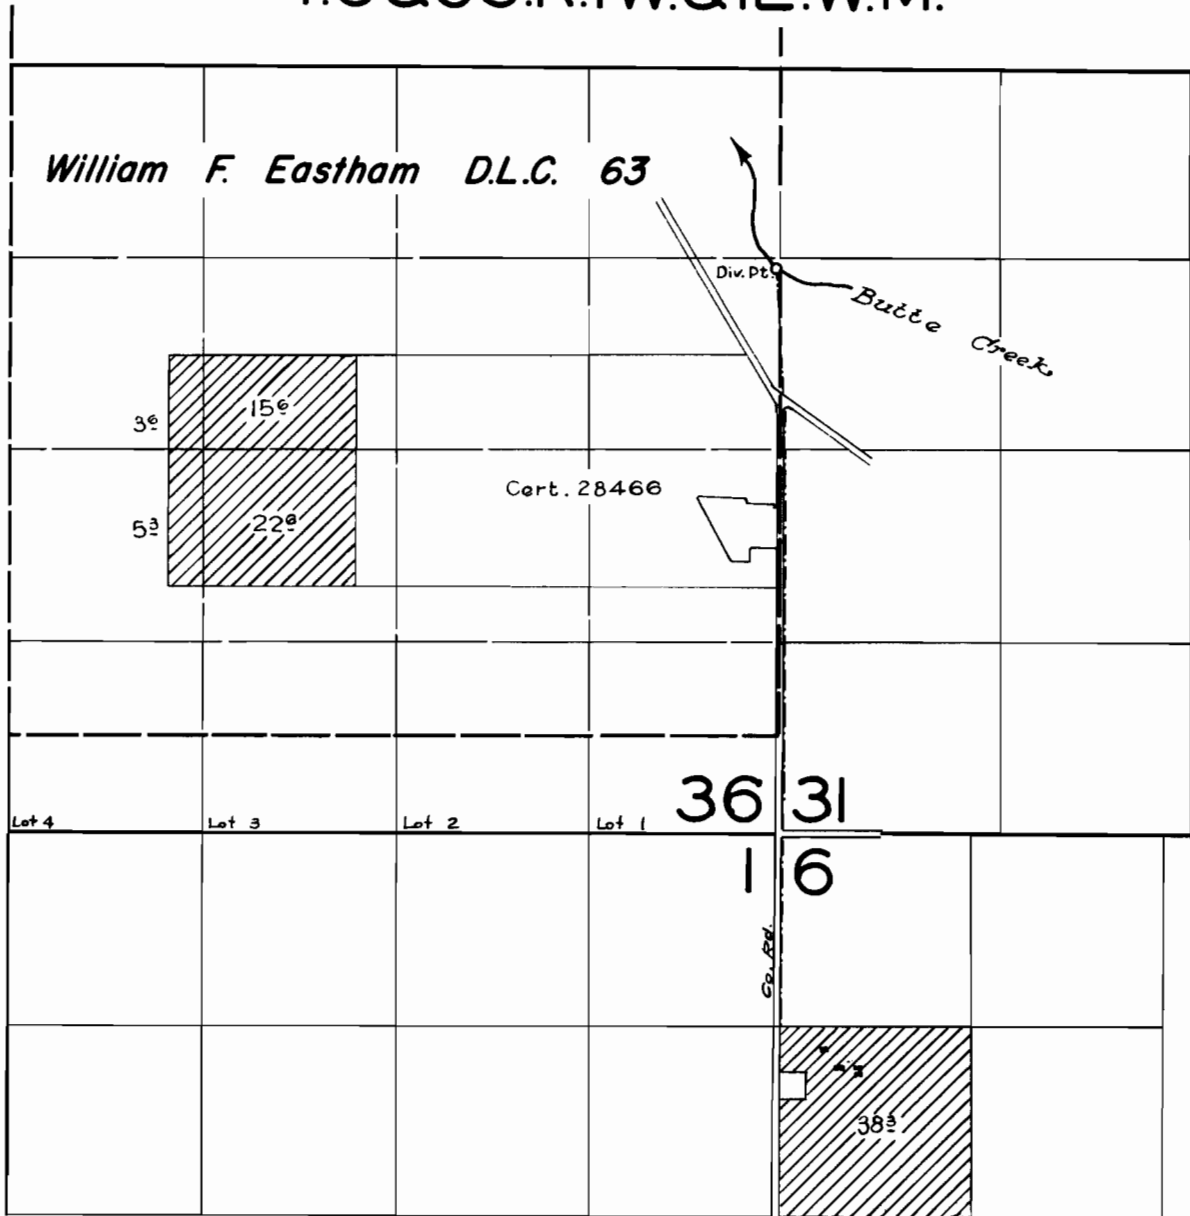

FINAL PROOF SURVEY
UNDER

Application No. 34462.. Permit No. 27068..
IN NAME OF

LOUIS BERNING

Surveyed April 16 1962, by *A. Jackson*