


T.5S.R.1W.W.M.

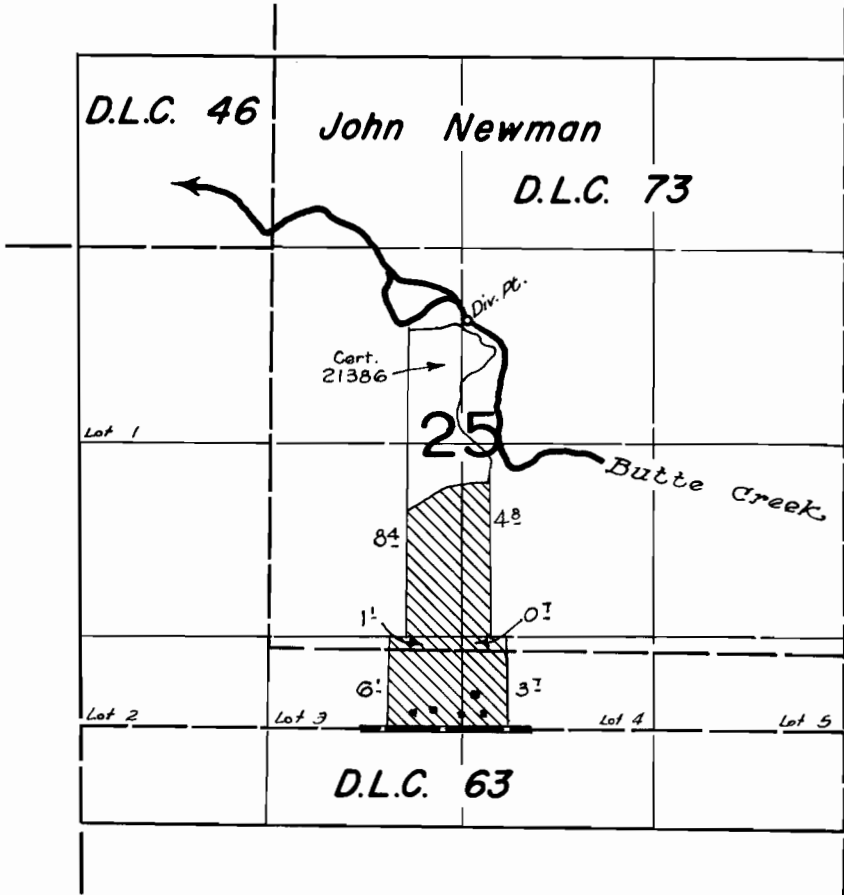

FINAL PROOF SURVEY
UNDER

Application No. 34551 Permit No. 27130
IN NAME OF

A. A. PAQUIN

Surveyed June 19, 1962, by *[Signature]*