


T.7S.R.1W.W.M.

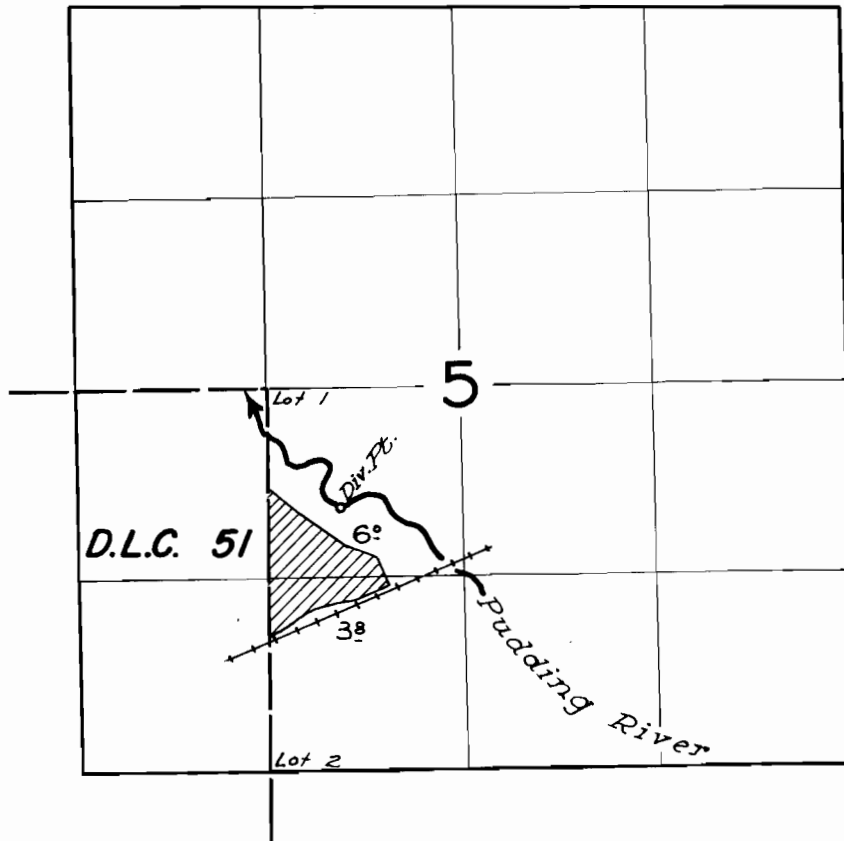

FINAL PROOF SURVEY
UNDER

Application No. 34675. Permit No. 27235.
IN NAME OF

LARRY LINCOLN

Surveyed May 17, 1962, by