


T. 2 N. R. 17 E. W.M.

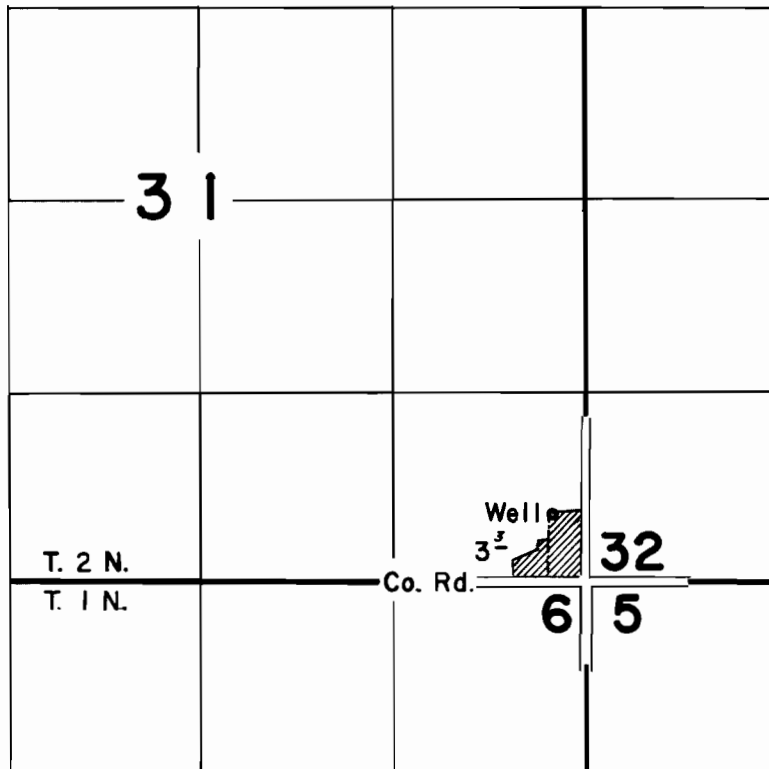

FINAL PROOF SURVEY
UNDER

Application No. U-866 Permit No. U-754
IN NAME OF

WASCO CEMETERY ASSOCIATION

Surveyed June 4, 1962, by *L. W. Gehousek*