


R35E

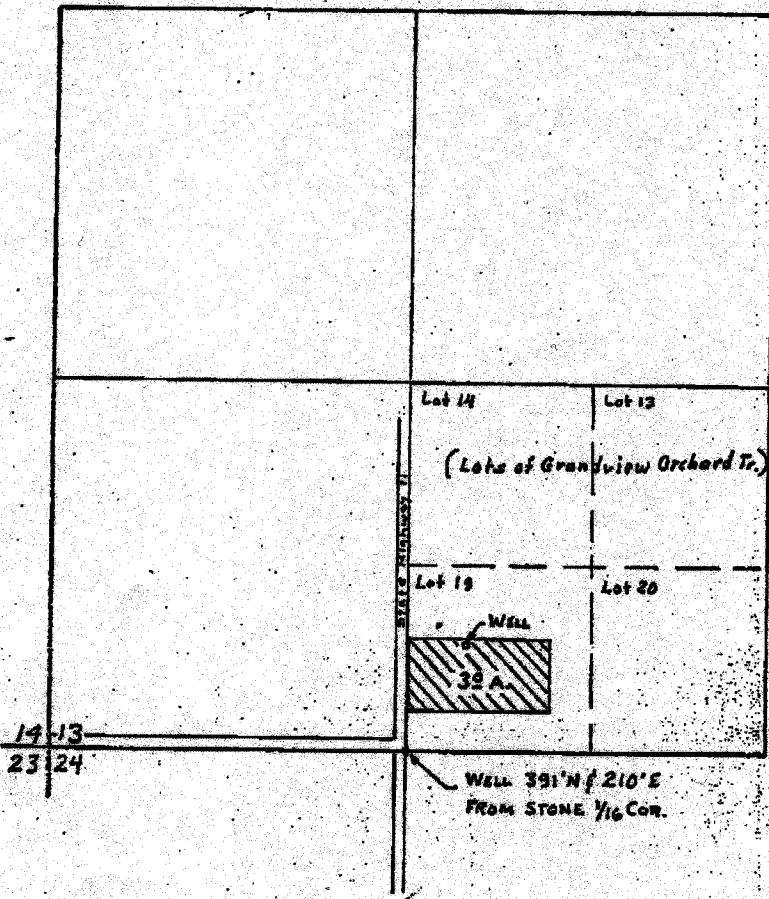

T6N

ROBERT Q. PERKINS

Application No. G-947
Permit No. G-855