


P# 6-980

T.2N.R.12E.W.M.

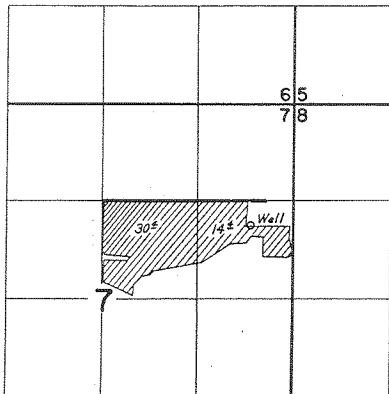

FINAL PROOF SURVEY  
UNDER

Application No. G-2525 Permit No. G-2340  
G-1092 G-980  
IN NAME OF

Albert Francois

Surveyed April 19, 1962, by Thomas B. Lauer