


T. 1 N. R. 13 E. W. M.

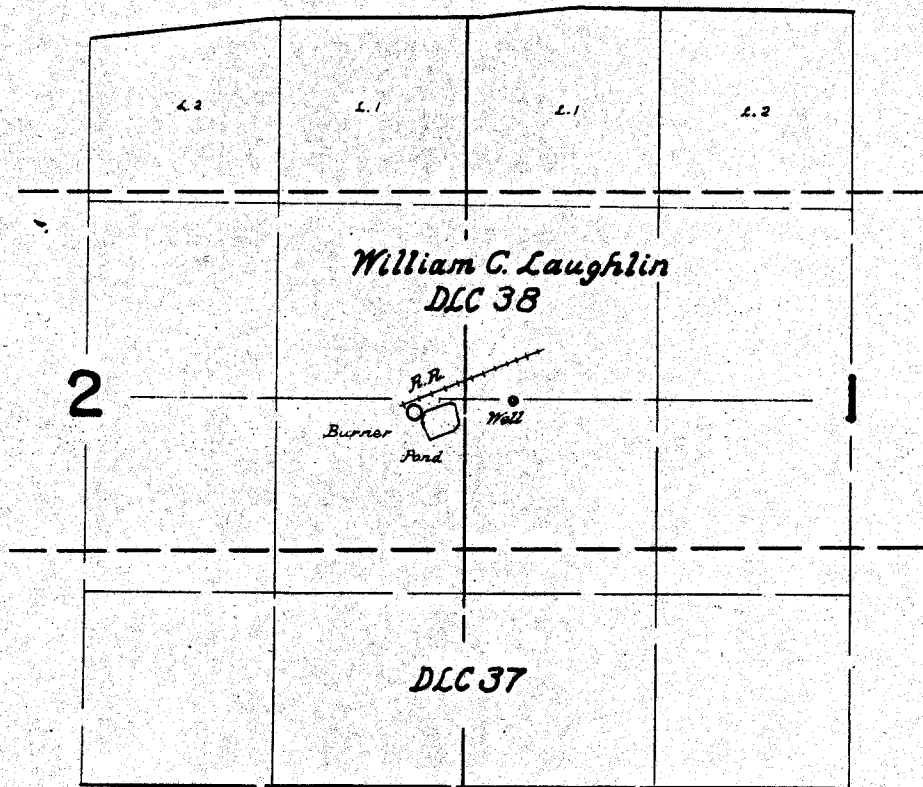

FINAL PROOF SURVEY UNDER

Application No. G-1171 Permit No. G-992
IN NAME OF

Seufert Electrometal Company

Surveyed April 16, 1962., by Thomas R. Lauer