


# T. 1 N. R. 14 E. W. M.

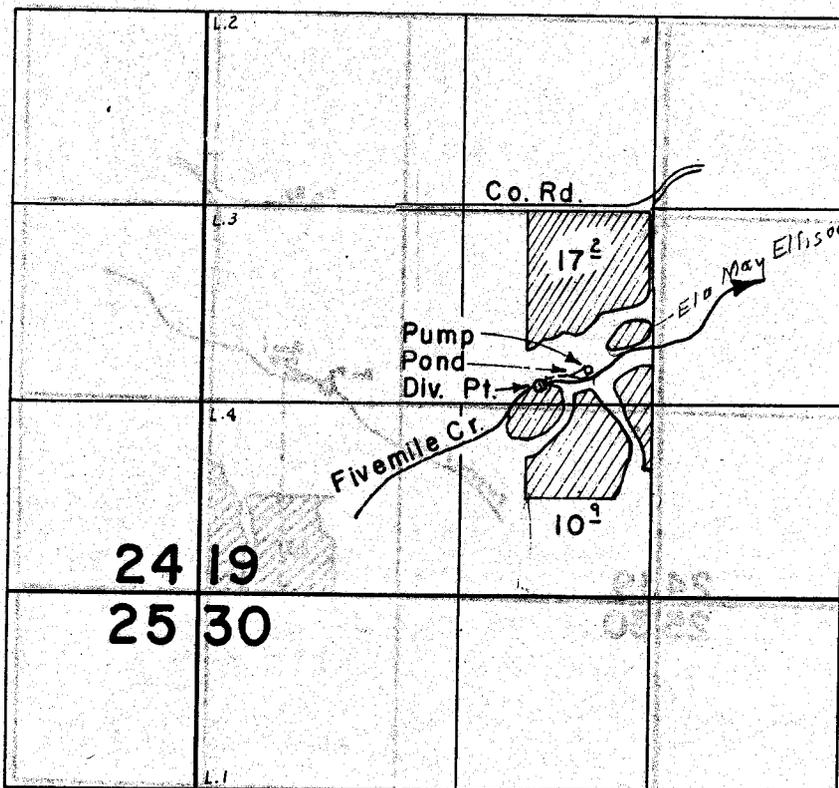

## FINAL PROOF SURVEY UNDER

Application No. 33859 Permit No. 26741  
IN NAME OF

HAROLD & DORIS RYAN

Surveyed April 5, 1962 by *L. W. Johnson*