


T. 2 S. R. 1 W. W. M.

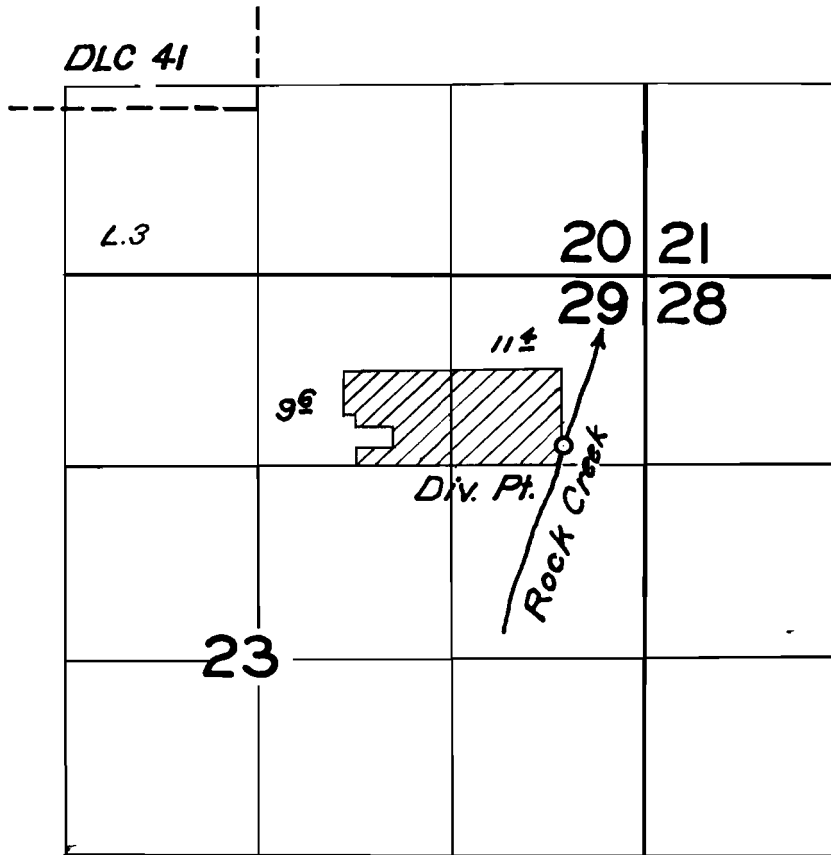

**FINAL PROOF SURVEY**  
UNDER

Application No. ~~32469~~ Permit No. ~~25637~~  
IN NAME OF

William Oldenburg

Surveyed 30 April 1962, by Carl R. Baker