


# T.1&2S.R.2W.W.M.

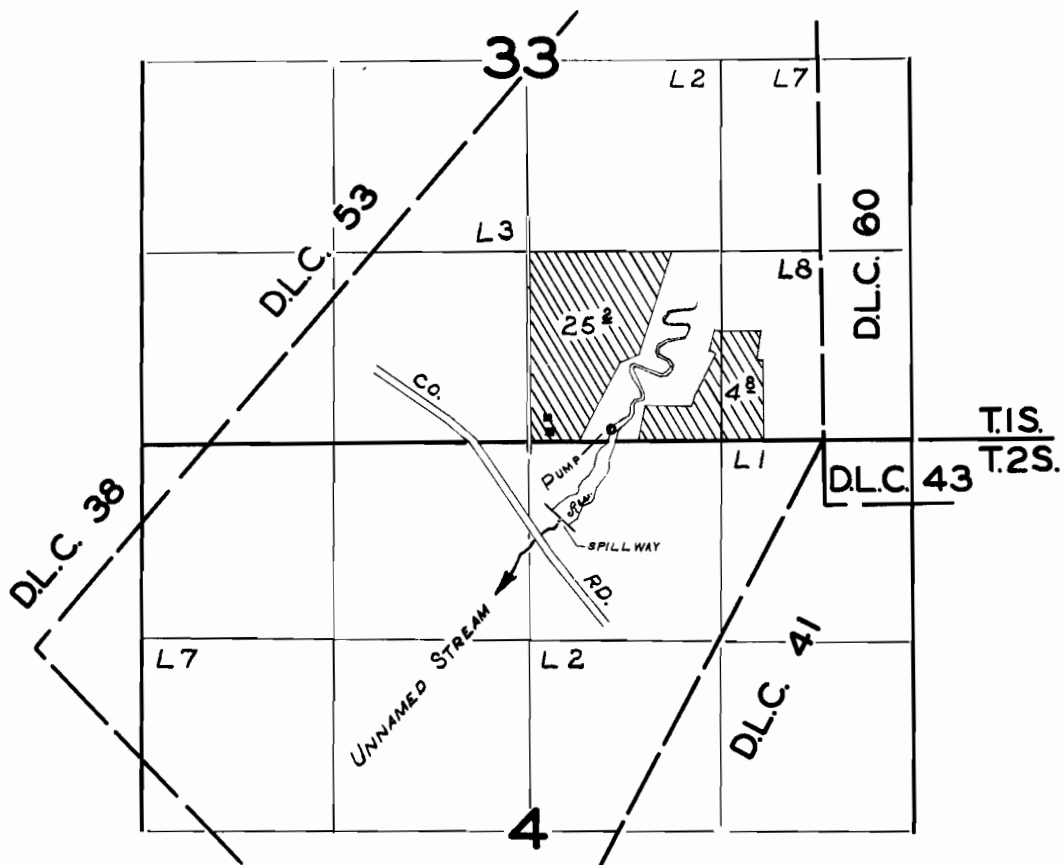

## FINAL PROOF SURVEY UNDER

R-32643 R-2178  
 Application No. 32644 Permit No. 25745  
 IN NAME OF

**W. A. PRIER**

Surveyed MAY 16 1960, by R. H. JACKSON  
SEPT. 28 61 C. O. BARTELS