


T.1&2S.R.2W.W.M.

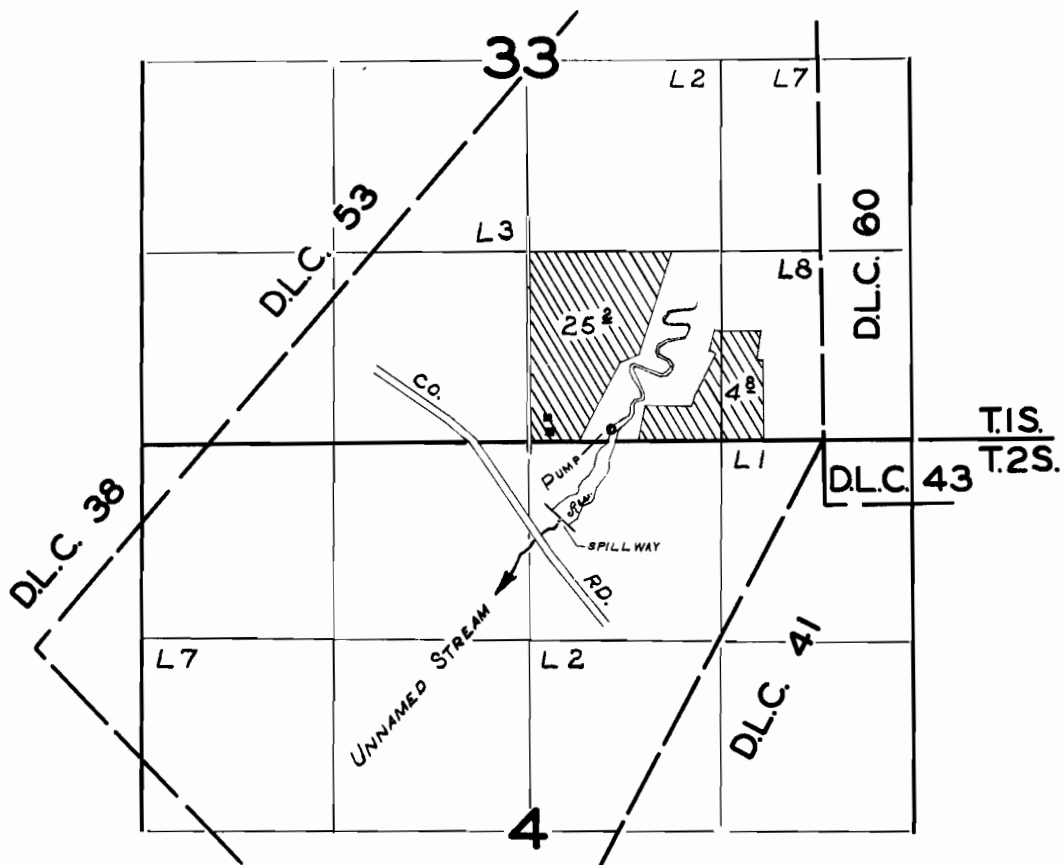

FINAL PROOF SURVEY UNDER

R-32643 R-2178
Application No. 32644 Permit No. 25745
IN NAME OF

W. A. PRIER

Surveyed MAY 16 1960, by R. H. JACKSON
SEPT. 28 61 C. O. BARTELS