


24111
30752

Application No. 30581
Permit No. 24111

RECEIVED
MAR 7 1956
STATE ENGINEER

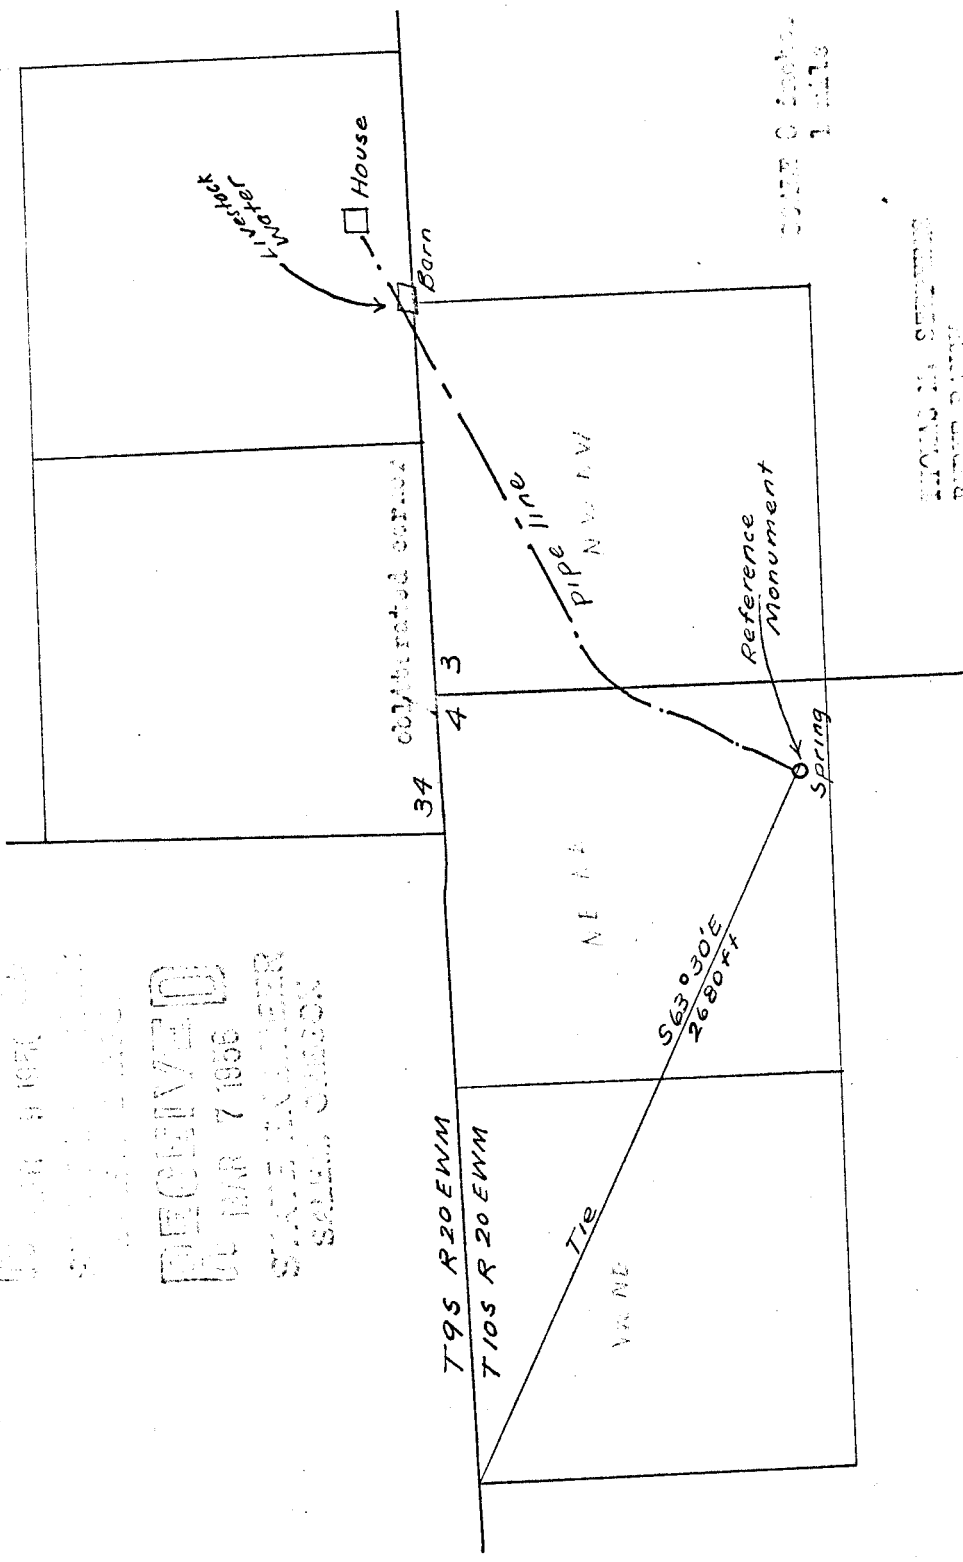

DATE 8/20/56
1 1/2

WILLIAM M. STEPHENS
