


In Upper Cemetery

T.M.F. and Sec 36

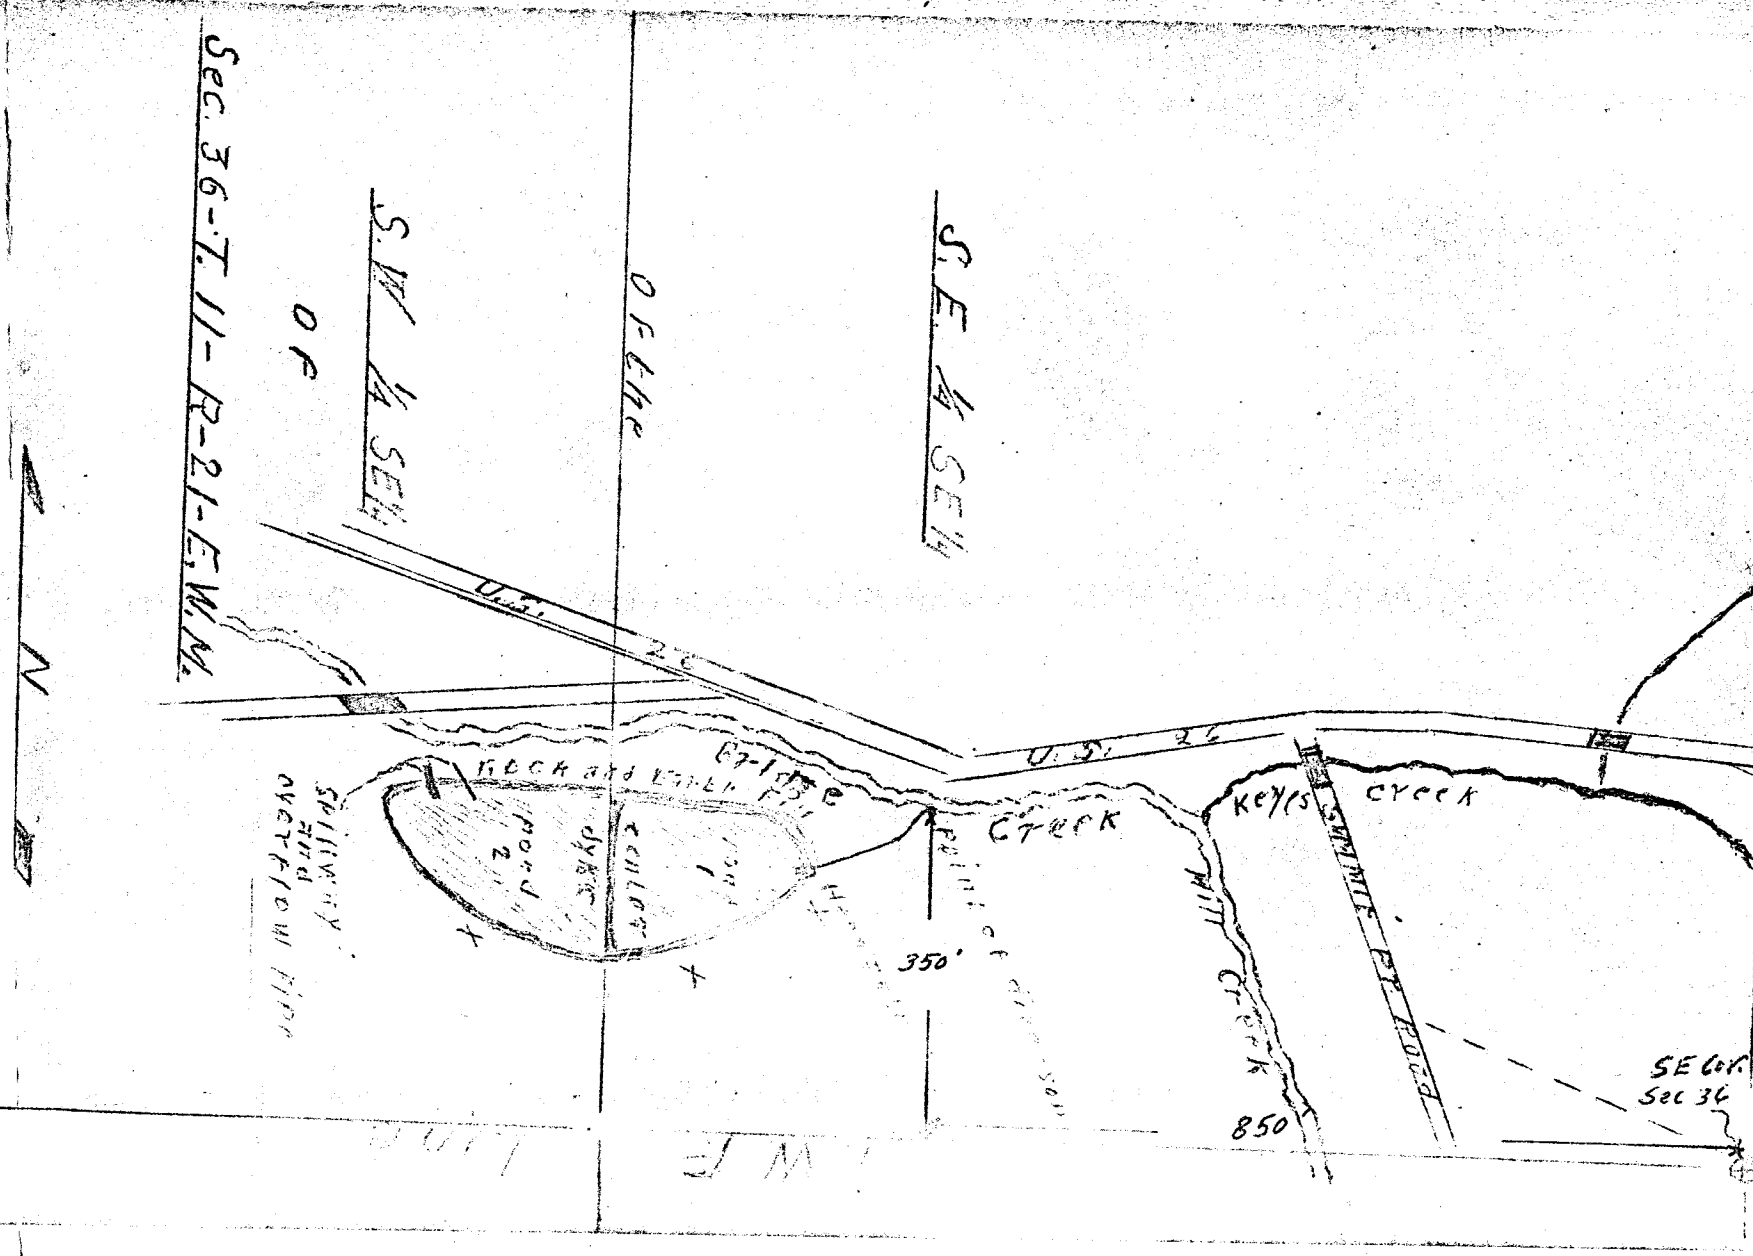

Sec. 36-T. 11-R-21-E.W.M.

OF

OF THE


SE COR.
Sec 36

850

350'

POINT of DISSECTION

WILL CREEK

KEYS CREEK

PT. ROAD

ROCK and LIME PILE

SPILLWAY
FIELD
OVERTFLOW PIPES

Dyke

EOLLOP

100'

E.W.M.

T. 11