



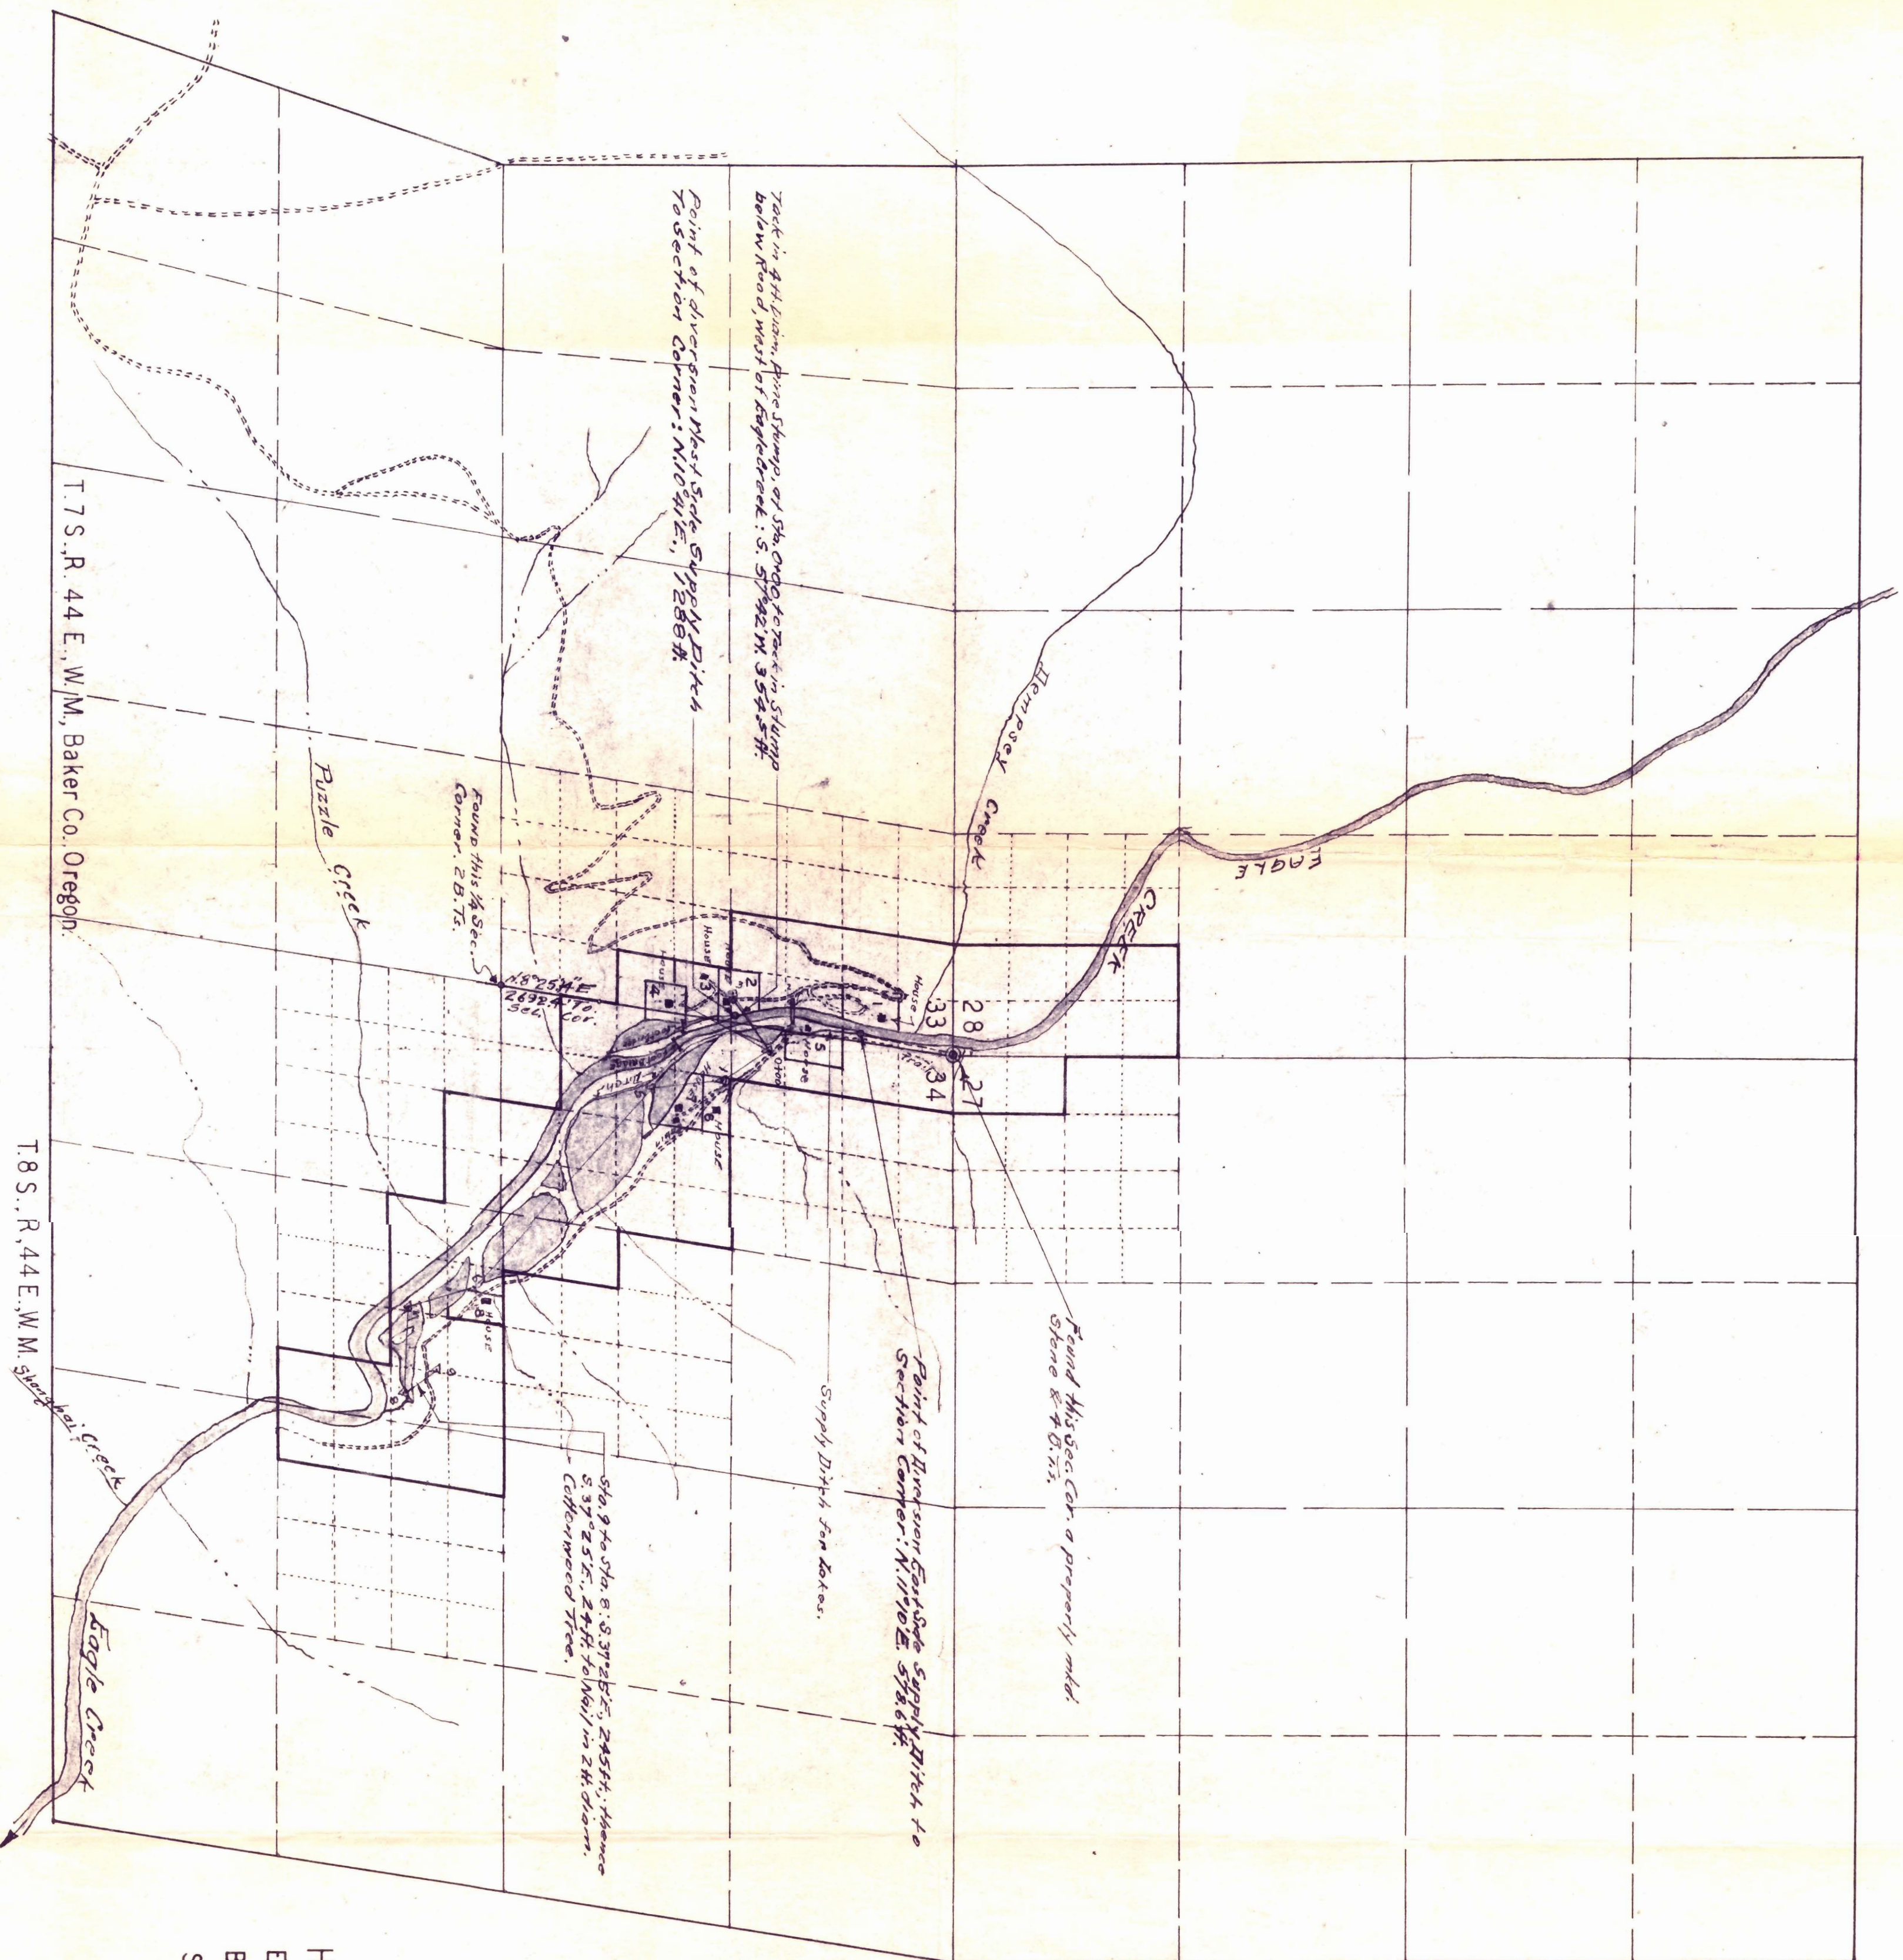

I, Philo H. Anderson, of Baker, Oregon, Certify that this map was made from notes taken during an actual survey made by me on July 10, 11, & 12, 1957; and that the monument shown on this map consists of a properly marked stone, as described in the official record, in a mound of washed boulders, witnessed by bearing trees, believed to have been scribed since the original survey, the Corner of Sections 27, 28, 33 and 34, T. 7 S., R. 44 E., W. M., in Baker Co., Oregon; from which the bearings and distances to the points of diversion are as indicated hereon, to the best of my knowledge and belief.

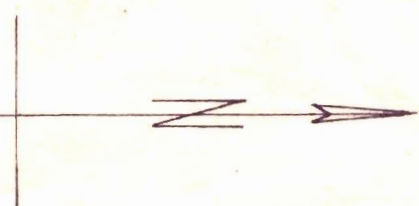

RECEIVED
DEC 26 1961
STATE ENGINEER
SALEM, OREGON
HIDEAWAY HILLS Inc..
EAGLE CREEK CANYON.
Baker Co., Oregon.
Scale: 1"=660'=40 Rods.
=10 Chains. 1/7920.