


T.I.S.R.4E.W.M.

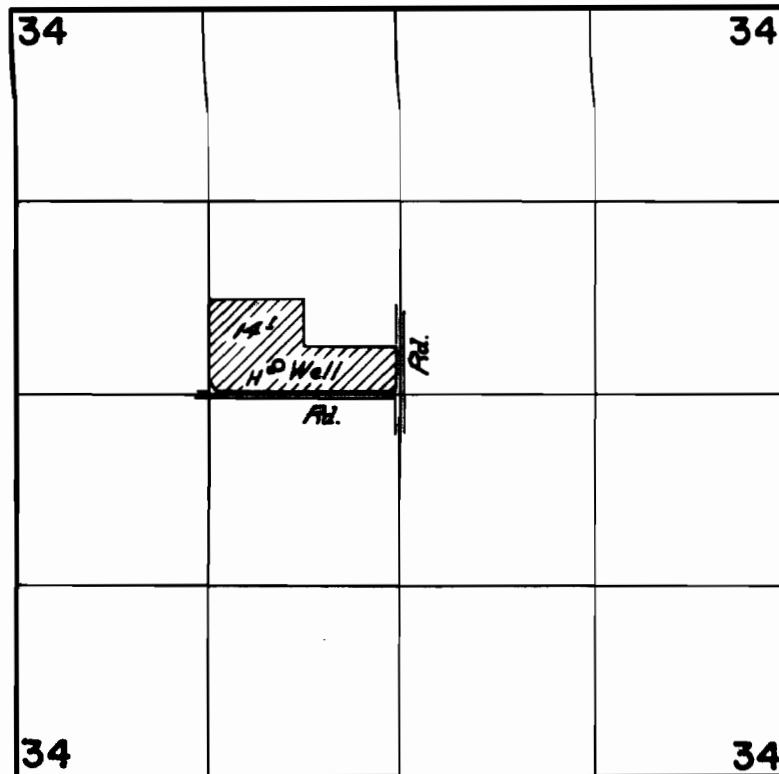

FINAL PROOF SURVEY
UNDER

Application No. G-836 Permit No. G-735
IN NAME OF

M. Suzuki

Surveyed May 29 1962, by Thomas R. Lauer