


T.2S.R.5E.W.M.

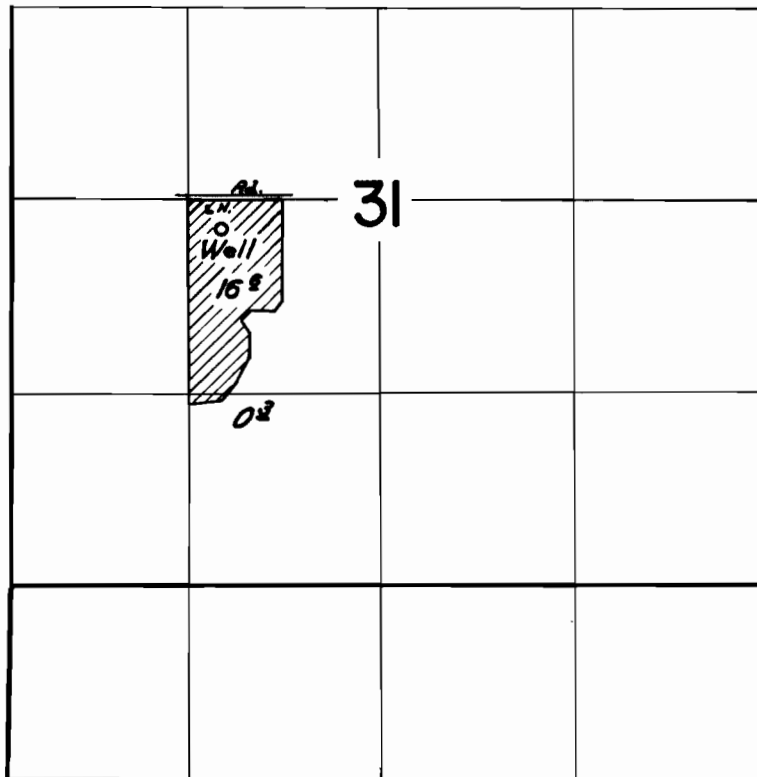

FINAL PROOF SURVEY
UNDER

Application No. *G-1291* Permit No. *G-1135*
IN NAME OF

Charles W. Heyer

Surveyed *May 31* 19*62*, by *Thomas R. Lauer*