


T.2S.R.4E.W.M.

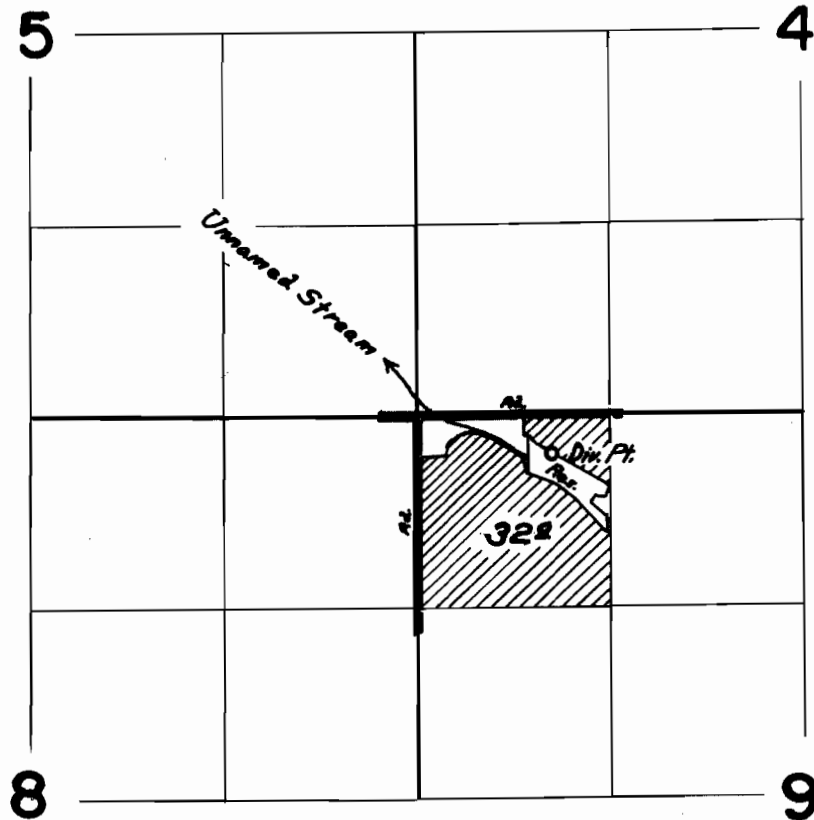

FINAL PROOF SURVEY
UNDER

Application No. *R-32061* Permit No. *R-2111*
32007 *25284*
IN NAME OF

P.O. Packard

Surveyed *May 31* 19*62*, by *Thomas R. Lauer*