


T.2S.R.2E.W.M.

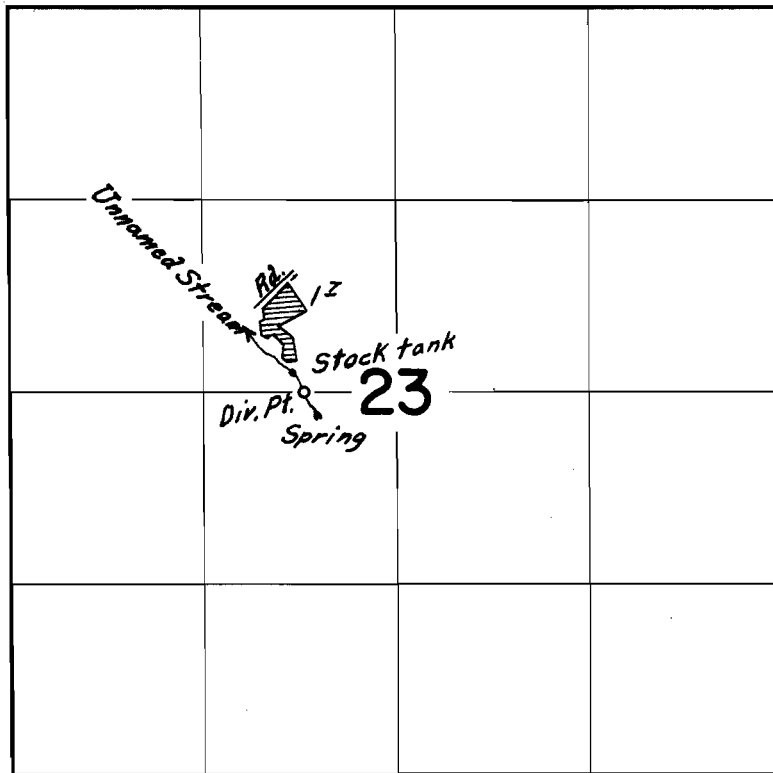

**FINAL PROOF SURVEY**  
UNDER

Application No. 32820 Permit No. 25940  
IN NAME OF

Theodore R. Free

Surveyed June 1 1962, by Thomas R. Lauer