


T.3S.R.1E.W.M.

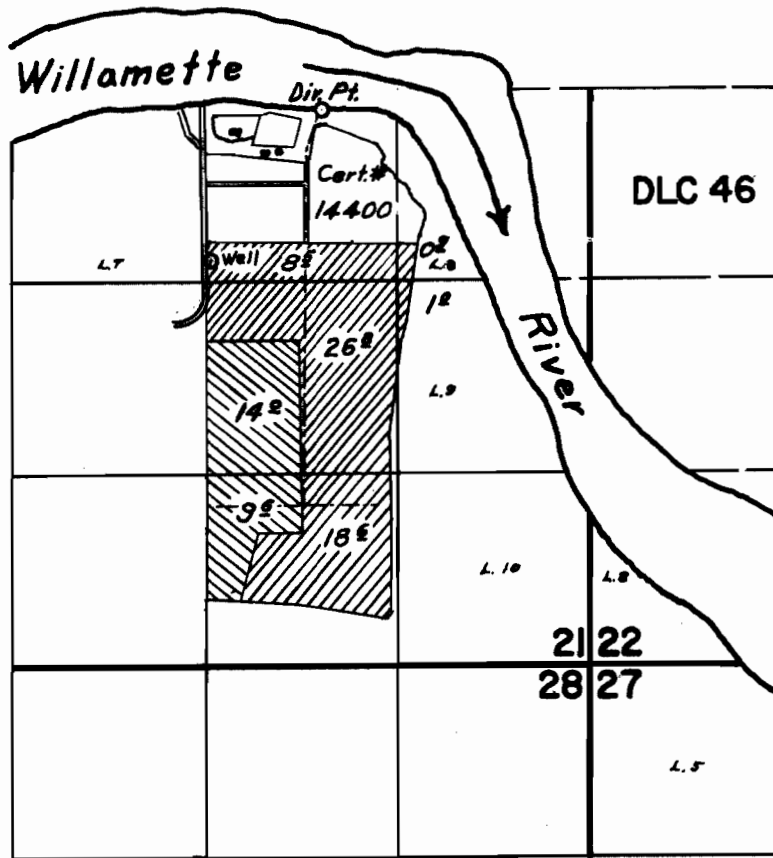

FINAL PROOF SURVEY UNDER

Application No. 37457 / 33106 Permit No. 27886 / 26170  
IN NAME OF

Paul, Virgil + Paul S. Montecucco

Surveyed April 24 1962, by Thomas R. Lauer