


T.5S.R.1W.W.M.

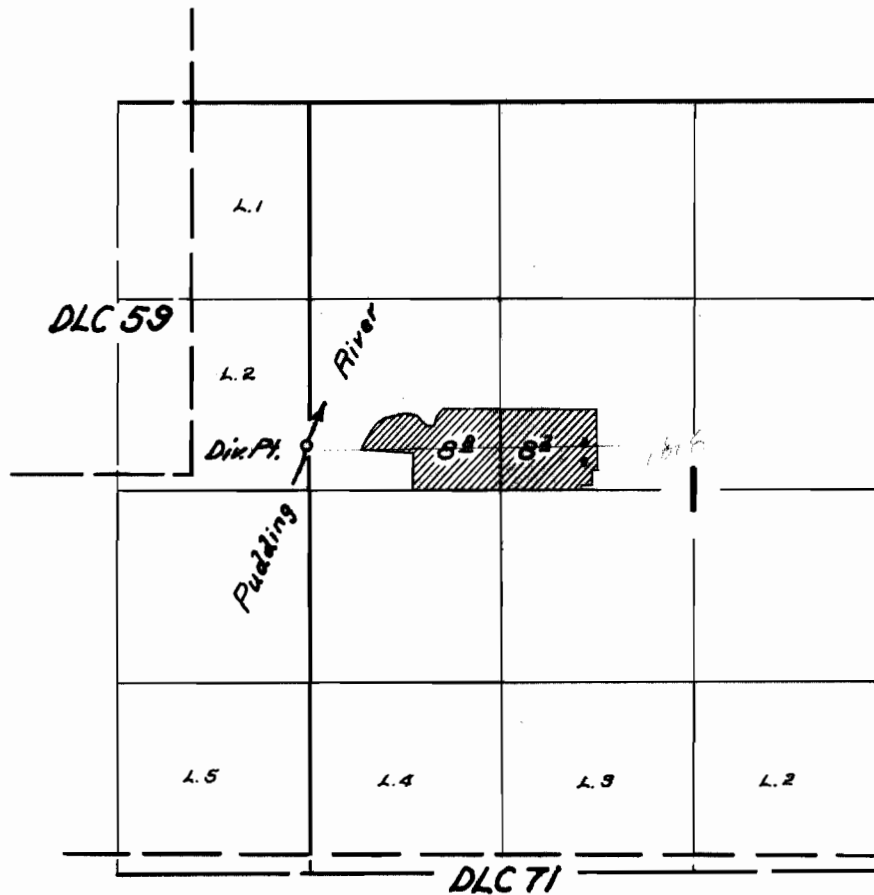

FINAL PROOF SURVEY UNDER

Application No. 33600 Permit No. 26569
IN NAME OF

Vladimir + Michael Kostrikin

Surveyed June 19 1962, by Thomas R. Lauer