


T.2S.R.2E.W.M.

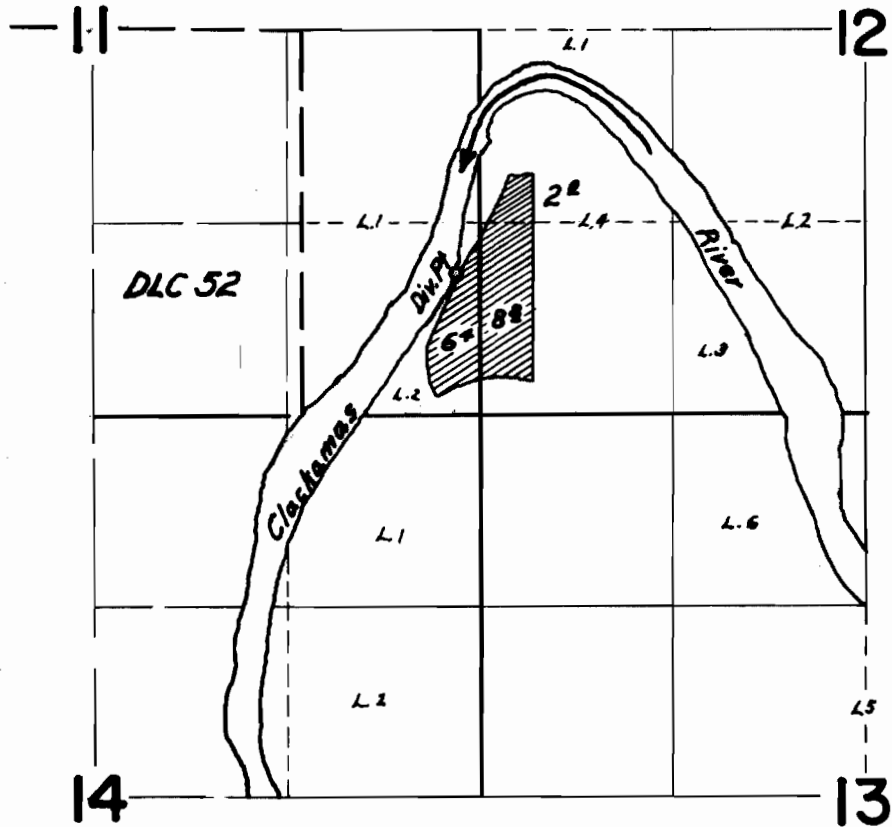

FINAL PROOF SURVEY UNDER

Application No. 34632 Permit No. 27205
IN NAME OF

Paul Scheff

Surveyed May 16 19 62, by Thomas R. Lauer