


# T.5S.R.3E.W.M.

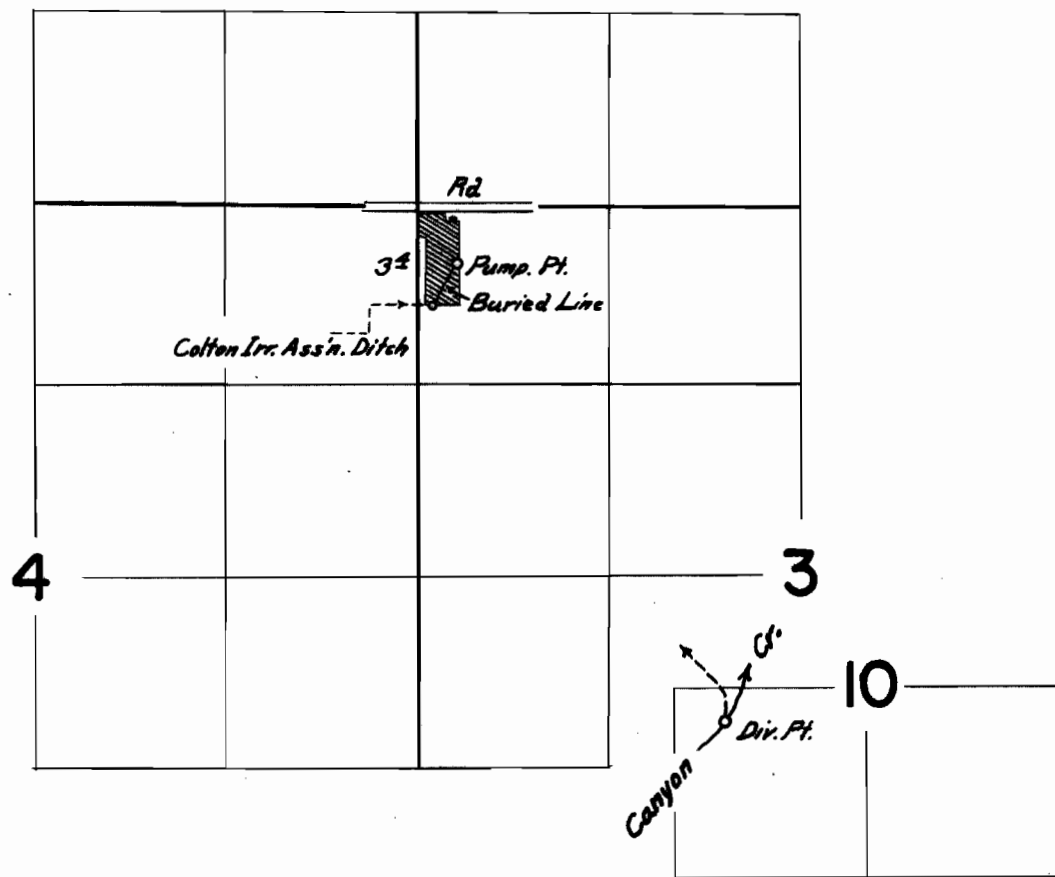

## FINAL PROOF SURVEY UNDER

Application No. 37135 Permit No. 27666  
IN NAME OF

Porter W. Norton

Surveyed June 20 1962, by Thomas R. Lauer