


T.3S.R.1E.W.M.

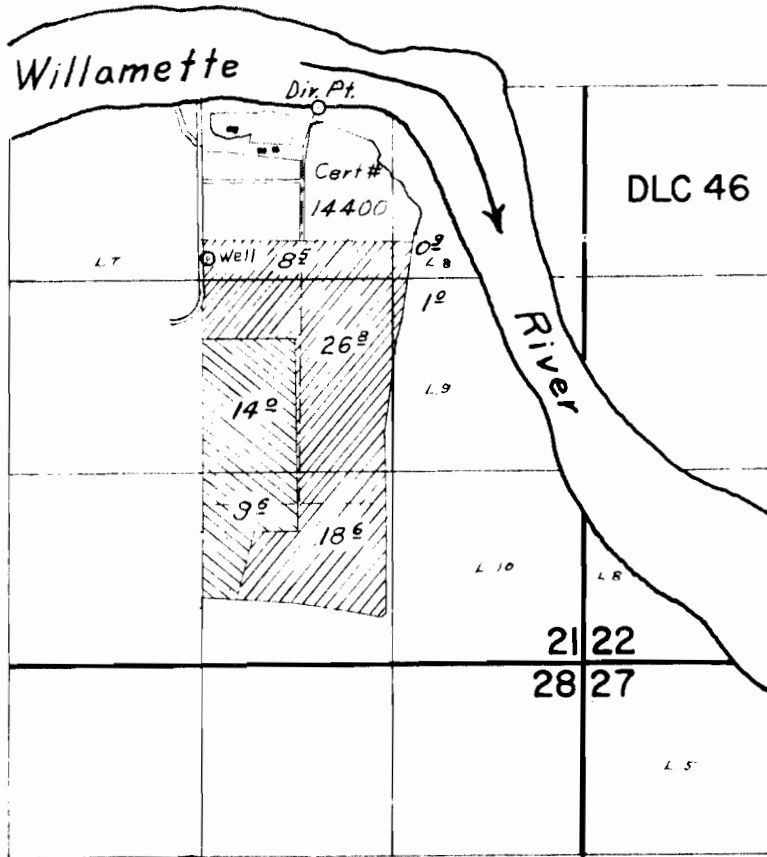

FINAL PROOF SURVEY

37457 27886
 33106 26170
 IN NAME OF

Paul, Virgil & Paul S. Montecucco

Survey of April 24 1962, by Thomas R. Lauer