


T.32S.R.5W.W.M.

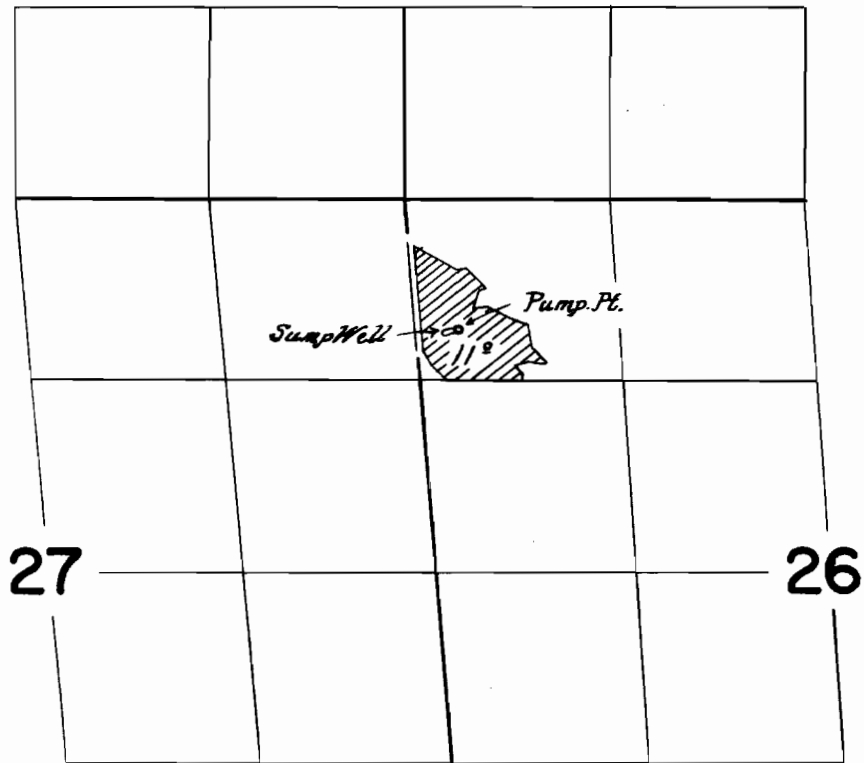

FINAL PROOF SURVEY UNDER

Application No. *G-1848* Permit No. *G-1691*
IN NAME OF

Shirley D. Palmer

Surveyed *August 7 1962*, by *Thomas R. Lauer*