


T.30S.R.5W.W.M.

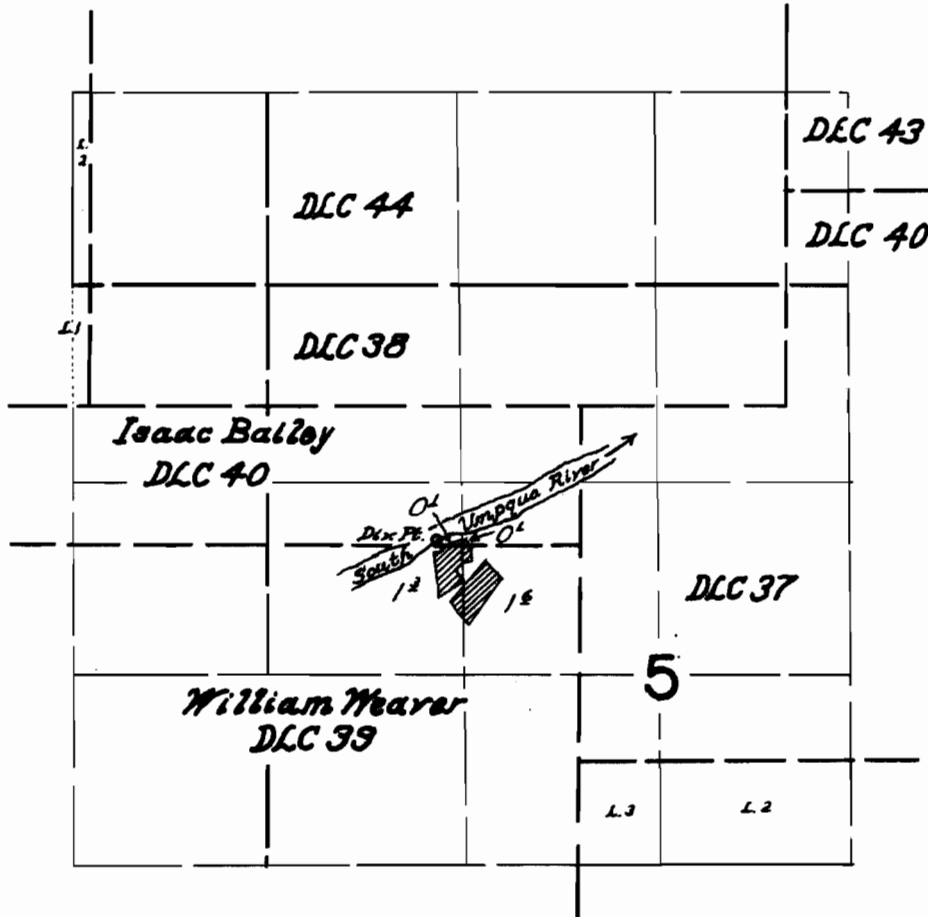

FINAL PROOF SURVEY UNDER

Application No. 32608... Permit No. 25784...
IN NAME OF

Dale Sall

Surveyed August 2, 1962, by Thomas R. Lauer