


T.33S.R.6W.W.M.

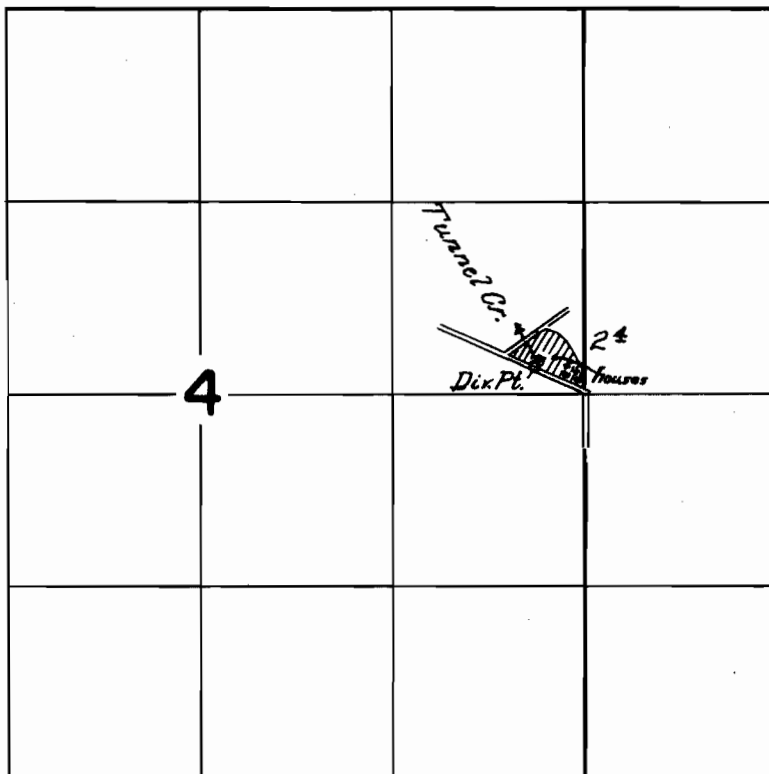

FINAL PROOF SURVEY
UNDER

Application No. 33028 Permit No. 26111.....
IN NAME OF

William H. + Myrtle M. Wunsch

Surveyed August 1, 1962, by Thomas R. Lauer