


T.30S.R.5W.W.M.

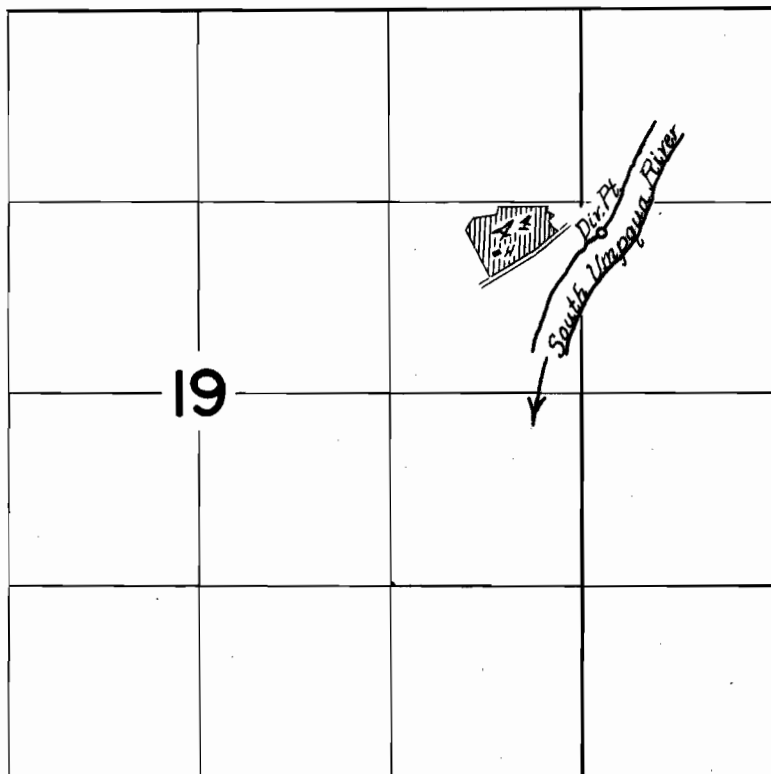

**FINAL PROOF SURVEY**  
UNDER

Application No. *37181* Permit No. *27685*  
IN NAME OF

.....*May George*.....

Surveyed *August 2, 1962*, by *Thomas R. Lauer*