


MAP DRAWN FROM FIELD NOTES OF A SURVEY
MADE BY ME ON JULY 22 1960. A THOROUGH
SEARCH WAS MADE FOR CORNERS BUT NOT
FOUND. SEC COR. LOCATION HAS BEEN
APPROXIMATED FROM PLANIMETRIC MAPS
AND AERIAL PHOTO. 57K-122

GLENN E TYLER
LAKEVIEW, ORE.

APPROX. LOC. SEC. COR.
CORNER GONE
NOT LOCATED

T28S
R16E 9 10
16 15

G1000
30784
FREMONT HIGHWAY

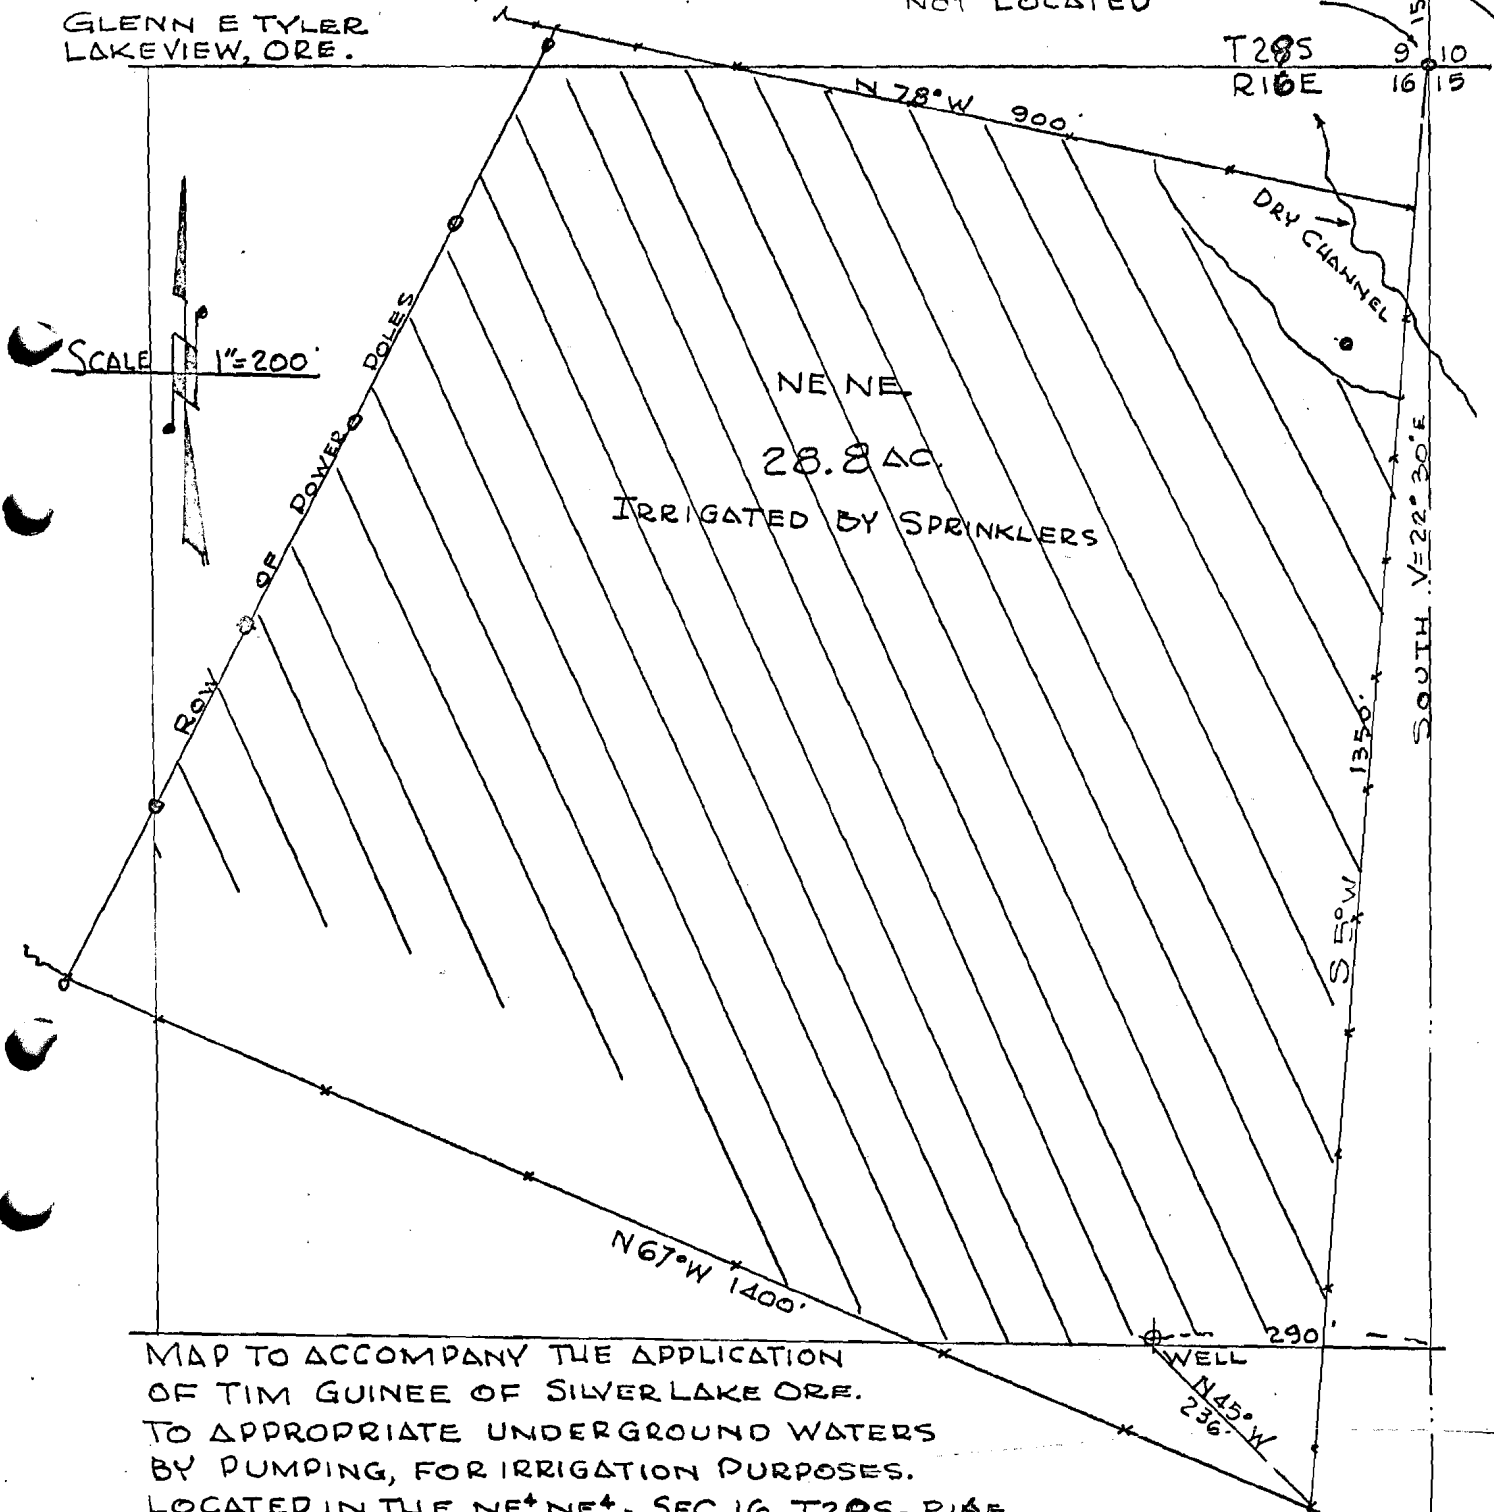

MAP TO ACCOMPANY THE APPLICATION
OF TIM GUINEE OF SILVER LAKE ORE.
TO APPROPRIATE UNDERGROUND WATERS
BY PUMPING, FOR IRRIGATION PURPOSES.
LOCATED IN THE NE 1/4 - SEC. 16. T28S - R16E.
LAKE COUNTY OREGON.

REGISTERED
OREGON
LAND SURVEYOR

Glenn E. Tyler
NOV 1943
GLENN E TYLER
250

Application No. G-1843
Permit No. G-1686

Searched for
but not located 16 15