


T.17S.R.3W.W.M.

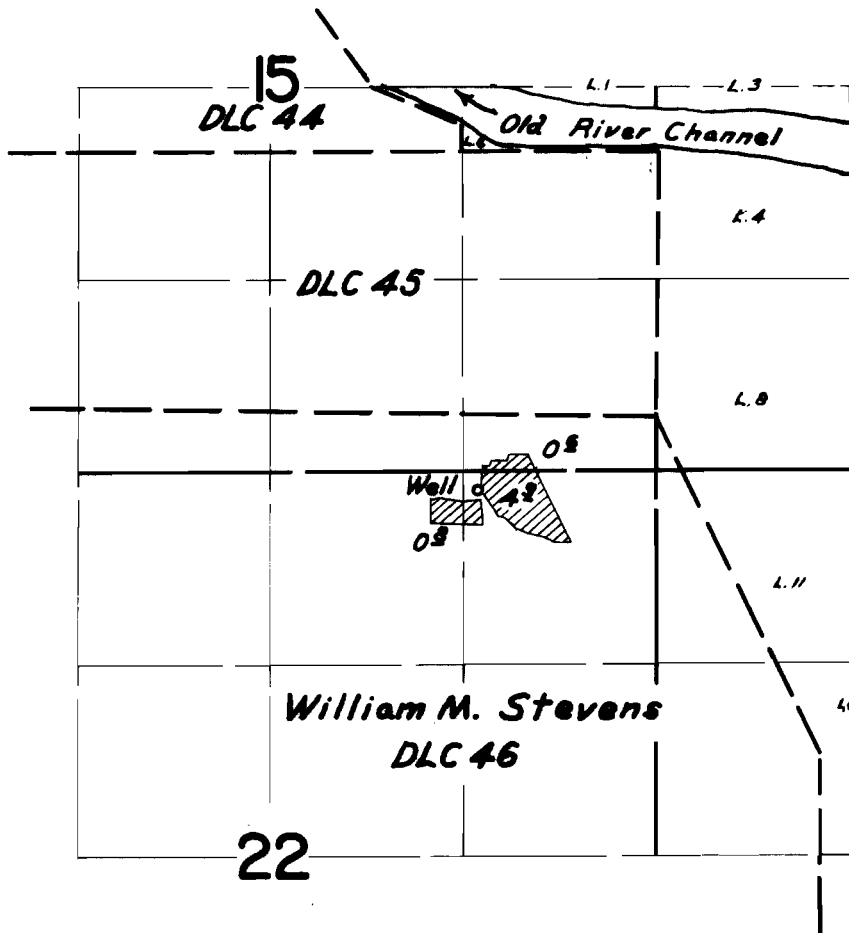

FINAL PROOF SURVEY UNDER

Application No. *G-1240* Permit No. *G-1120*
IN NAME OF

Robert F. Carpenter

Surveyed *May 21, 1962*, by *Thomas R. Lauer*