


T.15S.R.4W.W.M.

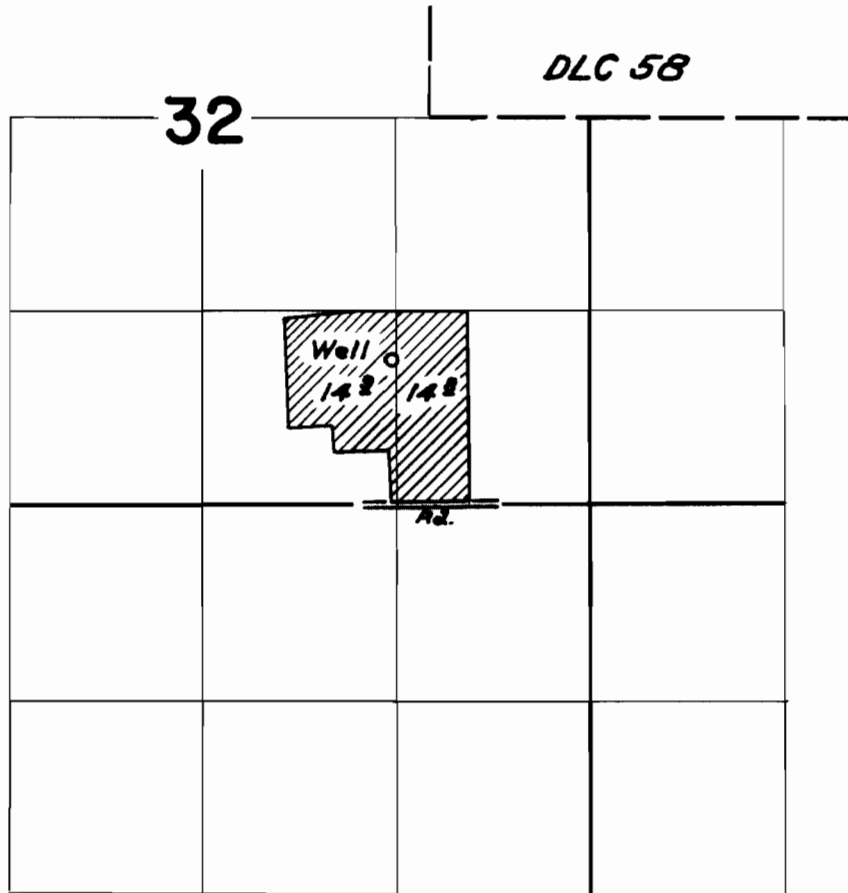

FINAL PROOF SURVEY
UNDER

Application No. *G-1422* Permit No. *G-1324*
IN NAME OF

A.L. Schwartz

Surveyed *Jan 9,* 1963, by *Thomas R. Lauer*